


LATITUDE

38° 30'

LONGITUDE 81° 25'

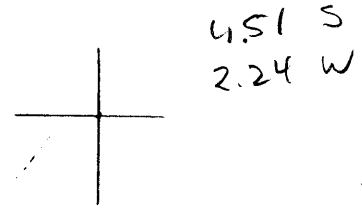

7'5 OGIS topo location

7.5' loc \_\_\_\_\_ 15' loc \_\_\_\_\_  
 \_\_\_\_\_ (calc.) \_\_\_\_\_

Company United Fuel

Farm James Jarrett 1

Quad Clendenin 15'

County Kanawha

District EIK

WELL LOCATION MAP

File No. 40227 70281

#219 in Kanawha  
1914 WVGES County Report