


LATITUDE 38° 30'

LONGITUDE 81° 25'

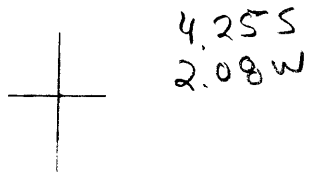

7'5 OGIS topo location

7.5' loc \_\_\_\_\_ 15' loc \_\_\_\_\_  
 \_\_\_\_\_ (calc.) \_\_\_\_\_

Company United Fuel

Farm Keeton Heirs 3

Quad Clendenin 15'

County Kanawha

District EIK

WELL LOCATION MAP

File No. 40237 70291

#229 in Kanawha  
 1914 WUGES County Report