


LATITUDE 38° 30'

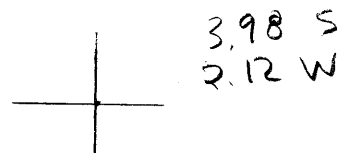

LONGITUDE 81° 25'

7'5 OGIS topo location

7.5' loc _____ 15' loc _____
 _____ (calc.) _____

Company Davidson & Gates

Farm Davidson & Gates 5

Quad Clendenin 15'

County Kanawha

District EIK

WELL LOCATION MAP

File No. 40243 70297

#235 in

1914 WV GCS Kanawha County Report