


LATITUDE 38°30'

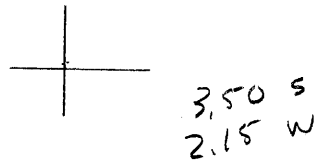

LONGITUDE

81°25'

7'5 OGIS topo location

7.5' loc _____ 15' loc _____
 _____ (calc.) _____

Company Judge Nidey & Kirtley

Farm J. H. Copenhaver I

Quad Clendenin 15'

County Kanawha

District EIR

WELL LOCATION MAP

File No. 40245 70299

#238 in Kanawha
1914 WVGES County Report