


LATITUDE 38° 30'

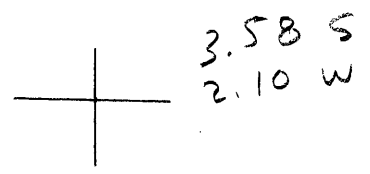

LONGITUDE 81° 25'

7.5 OGIS topo location

7.5' loc \_\_\_\_\_ 15' loc \_\_\_\_\_  
 (calc.) \_\_\_\_\_

Company Ohio Fuel

Farm J. H. Copenhagen 1

Quad Clendenin 15'

County Kanawha

District EIK

WELL LOCATION MAP

File No. 40250 70304

#243 in

1914 WV 625 Kanawha County Report