


LATITUDE 38°30'

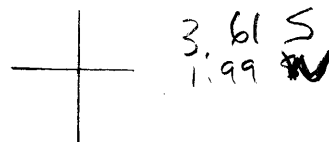

LONGITUDE 81°25'

7.5 OGIS topo location

7.5' loc \_\_\_\_\_ 15' loc \_\_\_\_\_  
 \_\_\_\_\_ (calc.) \_\_\_\_\_

Company Ohio Fuel

Farm Ethel Price 1

Quad Clendenin 15'

County Kanawha

District E1K

WELL LOCATION MAP

File No. 40253 70307

#246 in 1914 WV6ES

Kanawha County

Report