


LATITUDE 38°30'

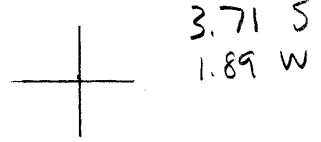

LONGITUDE 81°25'

7.5 OGIS topo location

7.5' loc _____ 15' loc _____
 _____ (calc.) _____

Company William S. Edwards Oil Co

Farm Kanawha & W.Va. 4

Quad Clendenin 15'

County Kanawha

District EIK

WELL LOCATION MAP

File No. 40254 70308

250 in Kanawha

RIYNGES County Report