


LATITUDE

38° 30'

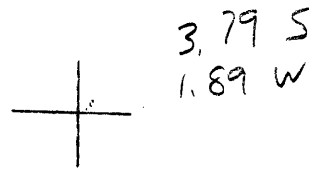

LONGITUDE 81° 25'

7.5 OGIS topo location

7.5' loc _____ 15' loc _____
 _____ (calc.) _____

Company William S. Edwards Oil Co
 Farm Kanawha E W.VA. 6
 Quad Clendenin 15'
 County Kanawha
 District EIK

WELL LOCATION MAP
 File No. 40263 70317
 #26 in Kanawha
 1914 WV GES County Report