


LATITUDE 38° 30'

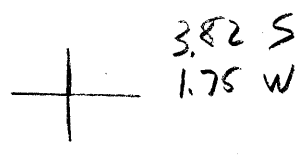

LONGITUDE 81° 25'

7.5 OGIS topo location

7.5' loc _____ 15' loc _____
 _____ (calc.) _____

Company Ohio Fuel
 Farm Chloe Copenhagen B
 Quad Clendenin 15'
 County Kanawha
 District ELK

WELL LOCATION MAP
 File No. 40265 70819
 # 263 in 1914 WUGES
 Kanawha County Report