


LATITUDE 38°30'

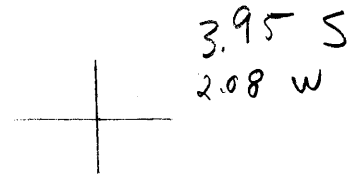

LONGITUDE 81°25'

7.5 OGIS topo location

7.5' loc _____ 15' loc _____
 _____ (calc.) _____

Company Ohio Fuel

Farm Chloe Copenhaver II

Quad Clendenin 15'

County Kanawha

District E1K

WELL LOCATION MAP

File No. 402 76 70330

275 in 1914 WVGES

Kanawha County Report