


LATITUDE 38°30'

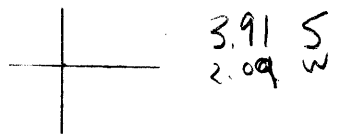

LONGITUDE 81°25'

7.5 OGIS topo location

7.5' loc _____ 15' loc _____
 _____ (calc.) _____

Company Amber Oil Co

Farm Price Heirs 2

Quad Clendenin 15'

County Kanawha

District EIK

WELL LOCATION MAP

File No. 40277 70331

276 in 1914 WUGES
Kanawha County
Report