


LATITUDE 38° 30'

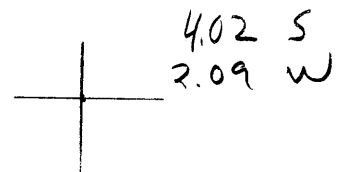

LONGITUDE 81° 25'

7.5 OGIS topo location

7.5' loc _____ 15' loc _____
 _____ (calc.) _____

Company Amber Oil Co

Farm Price Heirs 1

Quad Clendenin 15'

County Kanawha

District Elk

WELL LOCATION MAP

File No. 402 78 ~~70332~~

#277 in 1974 WVGES
Kanawha County
Report