


LATITUDE 38°30'

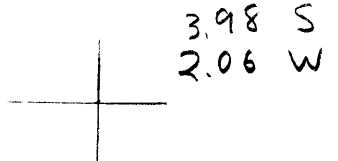

LONGITUDE 81°25'

7'5 OGIS topo location

7.5' loc _____ 15' loc _____
 (calc.) _____

Company Ohio Fuel

Farm Chloe Copenhaver 16

Quad Clendenin 15'

County Kanawha

District EIK

WELL LOCATION MAP

File No. 40279 70333

279 in 1914

WV GCS Kanawha County
Report