


LATITUDE

38° 30'

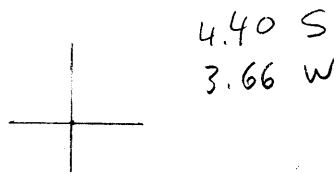

LONGITUDE 81° 25'

7'5 OGIS topo location

7.5' loc _____ 15' loc _____
 _____ (calc.) _____

Company Vernon Oil & Gas Co.

Farm Vernon Jarrett 1

Quad Cleudenin 15'

County Kanawha

District EIK

WELL LOCATION MAP

File No. 40317 70371

325 in 1914

WUGES Kanawha County Report