


LATITUDE 38° 30'

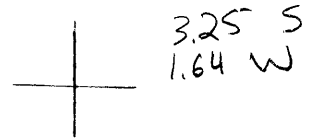

LONGITUDE 81° 25'

7.5 OGIS topo location

7.5' loc _____ 15' loc _____
 _____ (calc.) _____

Company South Penn

Farm Bannister Heirs 7

Quad Clendenin 15'

County Kanawha

District EIK

WELL LOCATION MAP

File No. 40387 70438

#400 in 1914 WVGES
Kanawha County Report