


LATITUDE 38° 30'

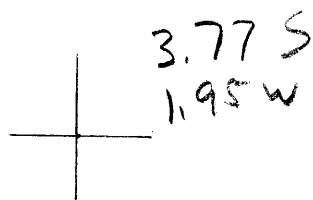

LONGITUDE 81° 25'

7'5 OGIS topo location

7.5' loc _____ 15' loc _____
 _____ (calc.) _____

Company _____ ?

Farm Grave Yard

Quad Clendenin 15'

County Kanawha

District E1K

WELL LOCATION MAP

File No. 40457 70508

476 in 1914 WGES

Kanawha county Report