


LATITUDE 38° 30'

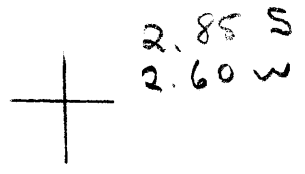

LONGITUDE 81° 20'

7'5 OGIS topo location

7.5' loc \_\_\_\_\_ 15' loc \_\_\_\_\_  
 \_\_\_\_\_ (calc.) \_\_\_\_\_

Company \_\_\_\_\_

Farm \_\_\_\_\_

Quad Clendenin 15'

County Kanawha

District Big Sandy

WELL LOCATION MAP

File No. 40538 70590

569 A in

1914 WVGES Kanawha

County Report