


LATITUDE

38°35'

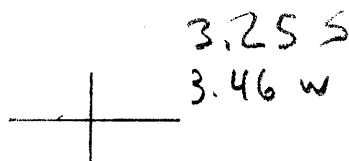

LONGITUDE

81°30'

7'5 OGIS topo location

7.5' loc \_\_\_\_\_ 15' loc \_\_\_\_\_  
 \_\_\_\_\_ (calc.) \_\_\_\_\_

Company Ohio Fuel

Farm R.C. Legg I.

Quad Charleston 15'

County Kanawha

District Union

WELL LOCATION MAP

File No. 40577 70621

# 611 in Kanawha  
County Report