


LATITUDE 38° 20'

LONGITUDE 81° 20'

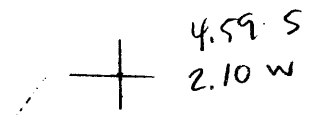

7'5 OGIS topo location

7.5' loc \_\_\_\_\_ 15' loc \_\_\_\_\_  
 \_\_\_\_\_ (calc.) \_\_\_\_\_

Company \_\_\_\_\_

Farm C.C. Lewis

Quad Montgomery 15'

County Kanawha

District Cabin Creek

WELL LOCATION MAP

File No. 40652 70683

# 685 in 1914 WVGES

Kanawha County  
Report