


LATITUDE 38°15'

LONGITUDE 81°25'

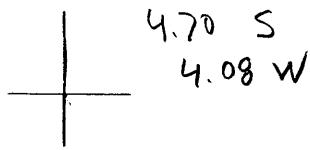

7.5 OGIS topo location

7.5' loc _____ 15' loc _____
 _____ (calc.) _____

Company _____

Farm Enoch Smith

Quad Montgomery 15'

County Kanawha

District Cabin Creek

WELL LOCATION MAP

File No. 40664 70694

#697 in 1914 WV6ES
Kanawha County
Report