


LATITUDE 38° 25'

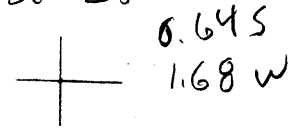

LONGITUDE 81° 20'

7.5 OGIS topo location

7.5' loc _____ 15' loc _____
 _____ (calc.) _____

Company South Penn
 Farm T. E. Meadows I
 Quad Clendenin 15'
 County Kanawha
 District EIK

WELL LOCATION MAP
 File No. 40681 70710
 #711 in 1914 WVGES
 Kanawha County Report