


LATITUDE 38° 25'

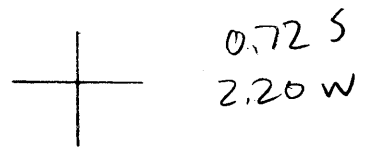

LONGITUDE 81° 20'

7.5 OGIS topo location

7.5' loc _____ 15' loc _____
 _____ (calc.) _____

Company South Penn

Farm D. R. Carnes 7

Quad Clendenin 15'

County Kanawha

District Big Sandy

WELL LOCATION MAP

File No. 40710 70738

* 741 in Kanawha
1914 WVGS County Report