


LATITUDE 38° 30'

LONGITUDE 81° 20'

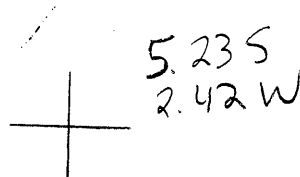

7'5 OGIS topo location

7.5' loc _____ 15' loc _____
 _____ (calc.) _____

Company Falling Rock Cannel Coal Co

Farm Weir 35

Quad Clendenin 15'

County Kanawha

District Big Sandy

WELL LOCATION MAP

File No. 40765 70792

#796 in Kanawha

1914 WVGES County Report