


LATITUDE 38° 30'

LONGITUDE 81° 20'

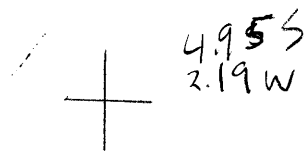

7'5 OGIS topo location

7.5' loc _____ 15' loc _____
 _____ (calc.) _____

Company Falling Rock Cannel Coal Co

Farm Weir 33

Quad Clendenin 15'

County Kanawha

District Big Sandy

WELL LOCATION MAP

File No. 40769 74796

800 in 1914 WVGES

Kanawha County Report