


LATITUDE 38° 30'

LONGITUDE 81° 20'

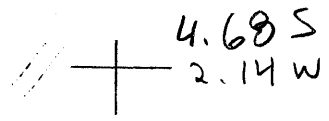

7.5 OGIS topo location

7.5' loc _____ 15' loc _____
 _____ (calc.) _____

Company Ohio Fuel

Farm GG Reynolds 1

Quad Clendenin 15'

County Kanawha

District Big Sandy

WELL LOCATION MAP

File No. 40775 20802

#806 in 1914 WVGS

Kanawha County Report