


LATITUDE 38°30'

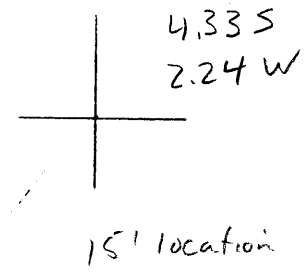

LONGITUDE 81°25'

7'5 OGIS topo location

7.5' loc _____ 15' loc _____
 _____ (calc.) _____

Company _____

Farm _____

Quad Clendenin 15'

County Kanawha

District EIK

WELL LOCATION MAP

File No. 9005

209 in 1914 WUGES
Kanawha County Report