


(FOL-SOM)  
4862/NE

Mapped, edited, and published by the Geological Survey  
Control by USGS and USC&GS  
Topography from aerial photographs by photogrammetric methods  
Aerial photographs taken 1957. Field check 1960  
Polyconic projection. 1927 North American datum  
10,000-foot grid based on West Virginia coordinate system,  
north zone  
1000-meter Universal Transverse Mercator grid ticks,  
zone 17, shown in blue

Fine red dashed lines indicate selected fence and field lines where  
'Glover Gap'; WV Scale: 1" = 0.379Mi 610Mtr 2,000Ft, 1 Mi = 2,640', 1 cm = 240Mtr

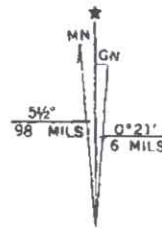


UTM GRID AND 1976 MAGNETIC NORTH  
DECLINATION AT CENTER OF SHEET

RECEIVED  
Office Of Oil and Gas

JAN 05 2026

WV Department of  
Environmental Protection

03/13/2026

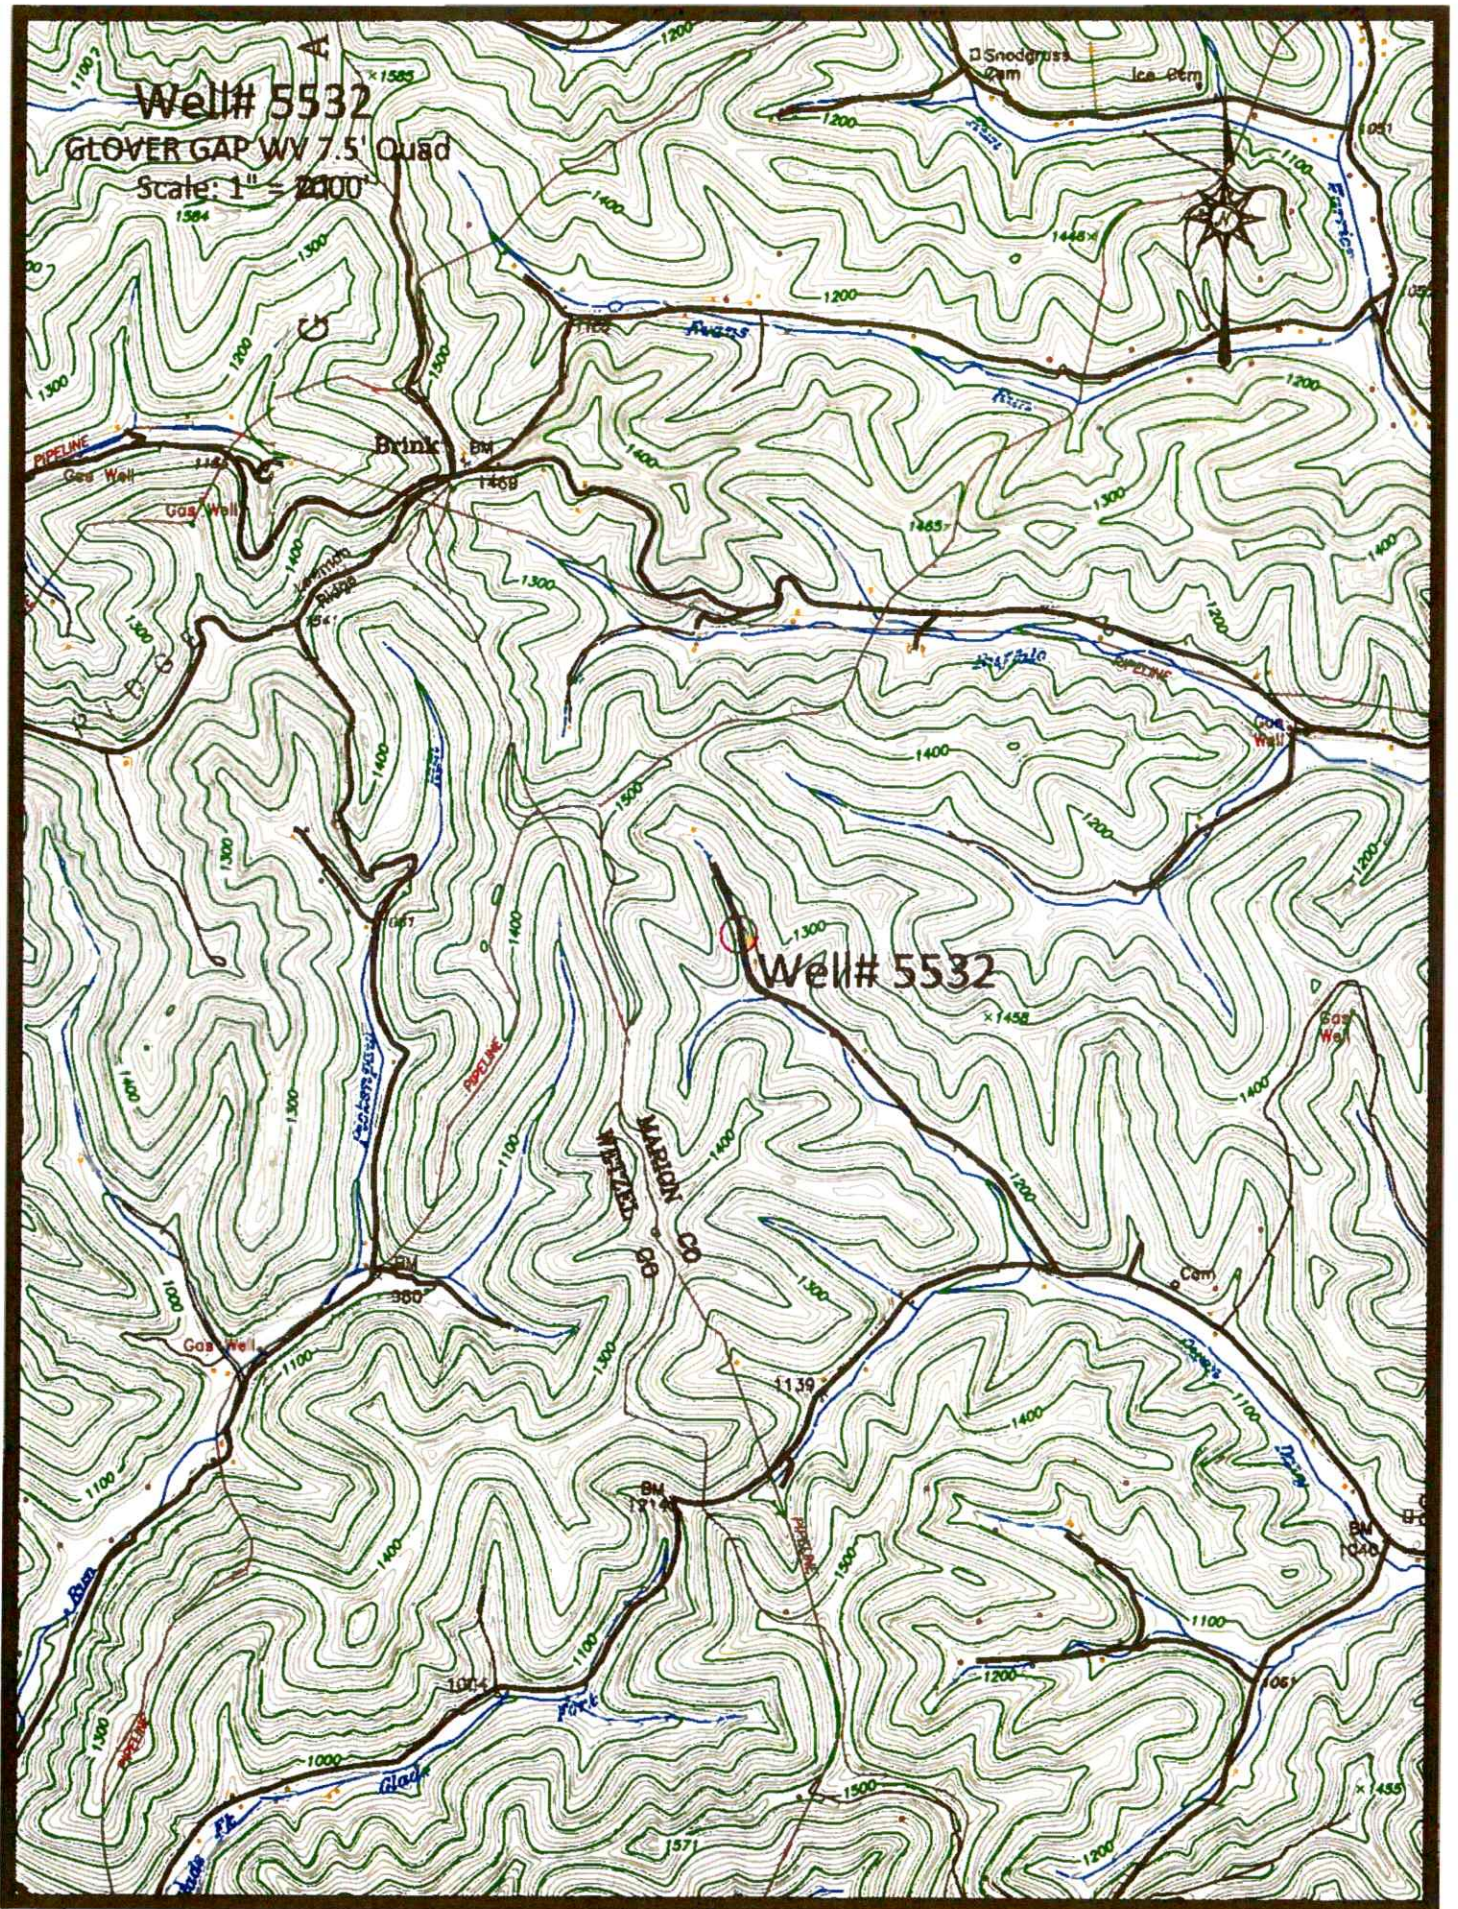

Access Road

03/13/2026

Well# 5532

GLOVER GAP WV 7.5' Quad

Scale: 1" = 500'



1500

1300

Well# 5532



MARY  
MARIO

1400

RECEIVED  
Office Of Oil and Gas


JAN 05 2026

WV Department of  
Environmental Protection

Area Row



03/13/2026

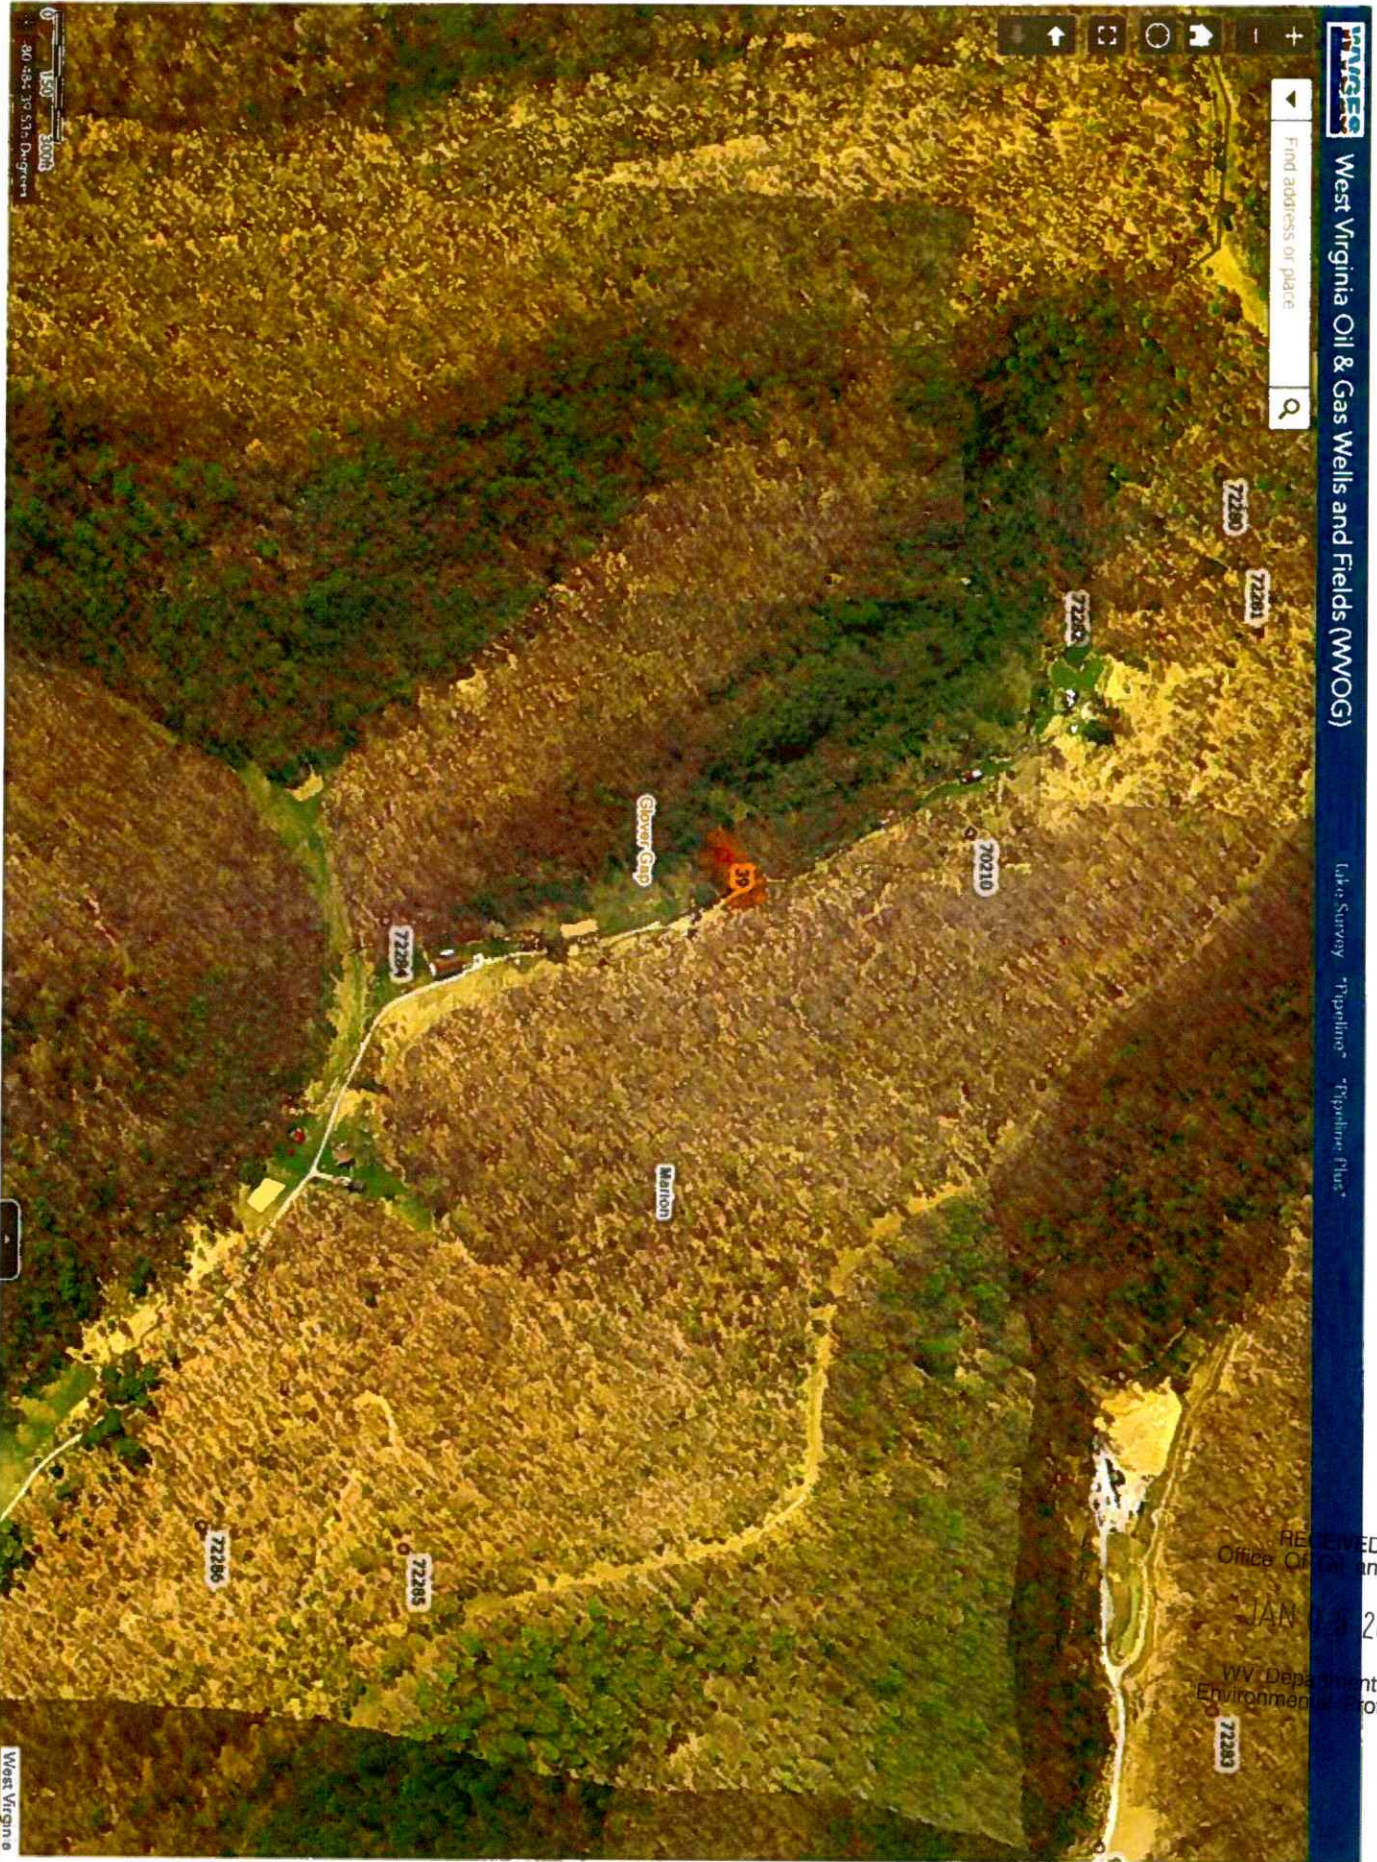

RECEIVED  
Office of Oil and Gas  
JAN 13 2026  
WV Department of  
Environmental Protection

03/13/2026

WW-7  
8-30-06



West Virginia Department of Environmental Protection  
Office of Oil and Gas

WELL LOCATION FORM: GPS

API: 47-049-00039 WELL NO.: 5532

FARM NAME: JOS. T. SATTERFIELD

RESPONSIBLE PARTY NAME: WEST VIRGINIA LAND RESOURCES INC.

COUNTY: MARION DISTRICT: MANNINGTON

QUADRANGLE: GLOVER GAP W.VA

SURFACE OWNER: JOHN R. & CONNIE M. MYERS

ROYALTY OWNER: \_\_\_\_\_

UTM GPS NORTHING: 4,376,261 m

UTM GPS EASTING: 544,533 m GPS ELEVATION: 358 m

The Responsible Party named above has chosen to submit GPS coordinates in lieu of preparing a new well location plat for a plugging permit or assigned API number on the above well. The Office of Oil and Gas will not accept GPS coordinates that do not meet the following requirements:

- Datum: NAD 1983, Zone: 17 North, Coordinate Units: meters, Altitude: height above mean sea level (MSL) - meters.
- Accuracy to Datum - 3.05 meters
- Data Collection Method:

Survey grade GPS \_\_\_\_\_: Post Processed Differential \_\_\_\_\_  
 \_\_\_\_\_ Real-Time Differential \_\_\_\_\_  
 Mapping Grade GPS X: Post Processed Differential X  
 \_\_\_\_\_ Real-Time Differential \_\_\_\_\_

- Letter size copy of the topography map showing the well location.

I the undersigned, hereby certify this data is correct to the best of my knowledge and belief and shows all the information required by law and the regulations issued and prescribed by the Office of Oil and Gas.

[Signature] \_\_\_\_\_ PS2002 \_\_\_\_\_ DECEMBER 10, 2025  
 Signature Title Date

RECEIVED  
Office Of Oil and Gas  
JAN 05 2025  
WV Department of  
Environmental Protection