

Well# 8316

HUNDRED WV / PA 715 QUAD


Scale: 1" = 2000'

Well# 8316  
MANNINGTON

RECEIVED  
Office of Oil and Gas  
MAR 13 2026  
WV Department of  
Environmental Protection

 Access Road

05/01/2026

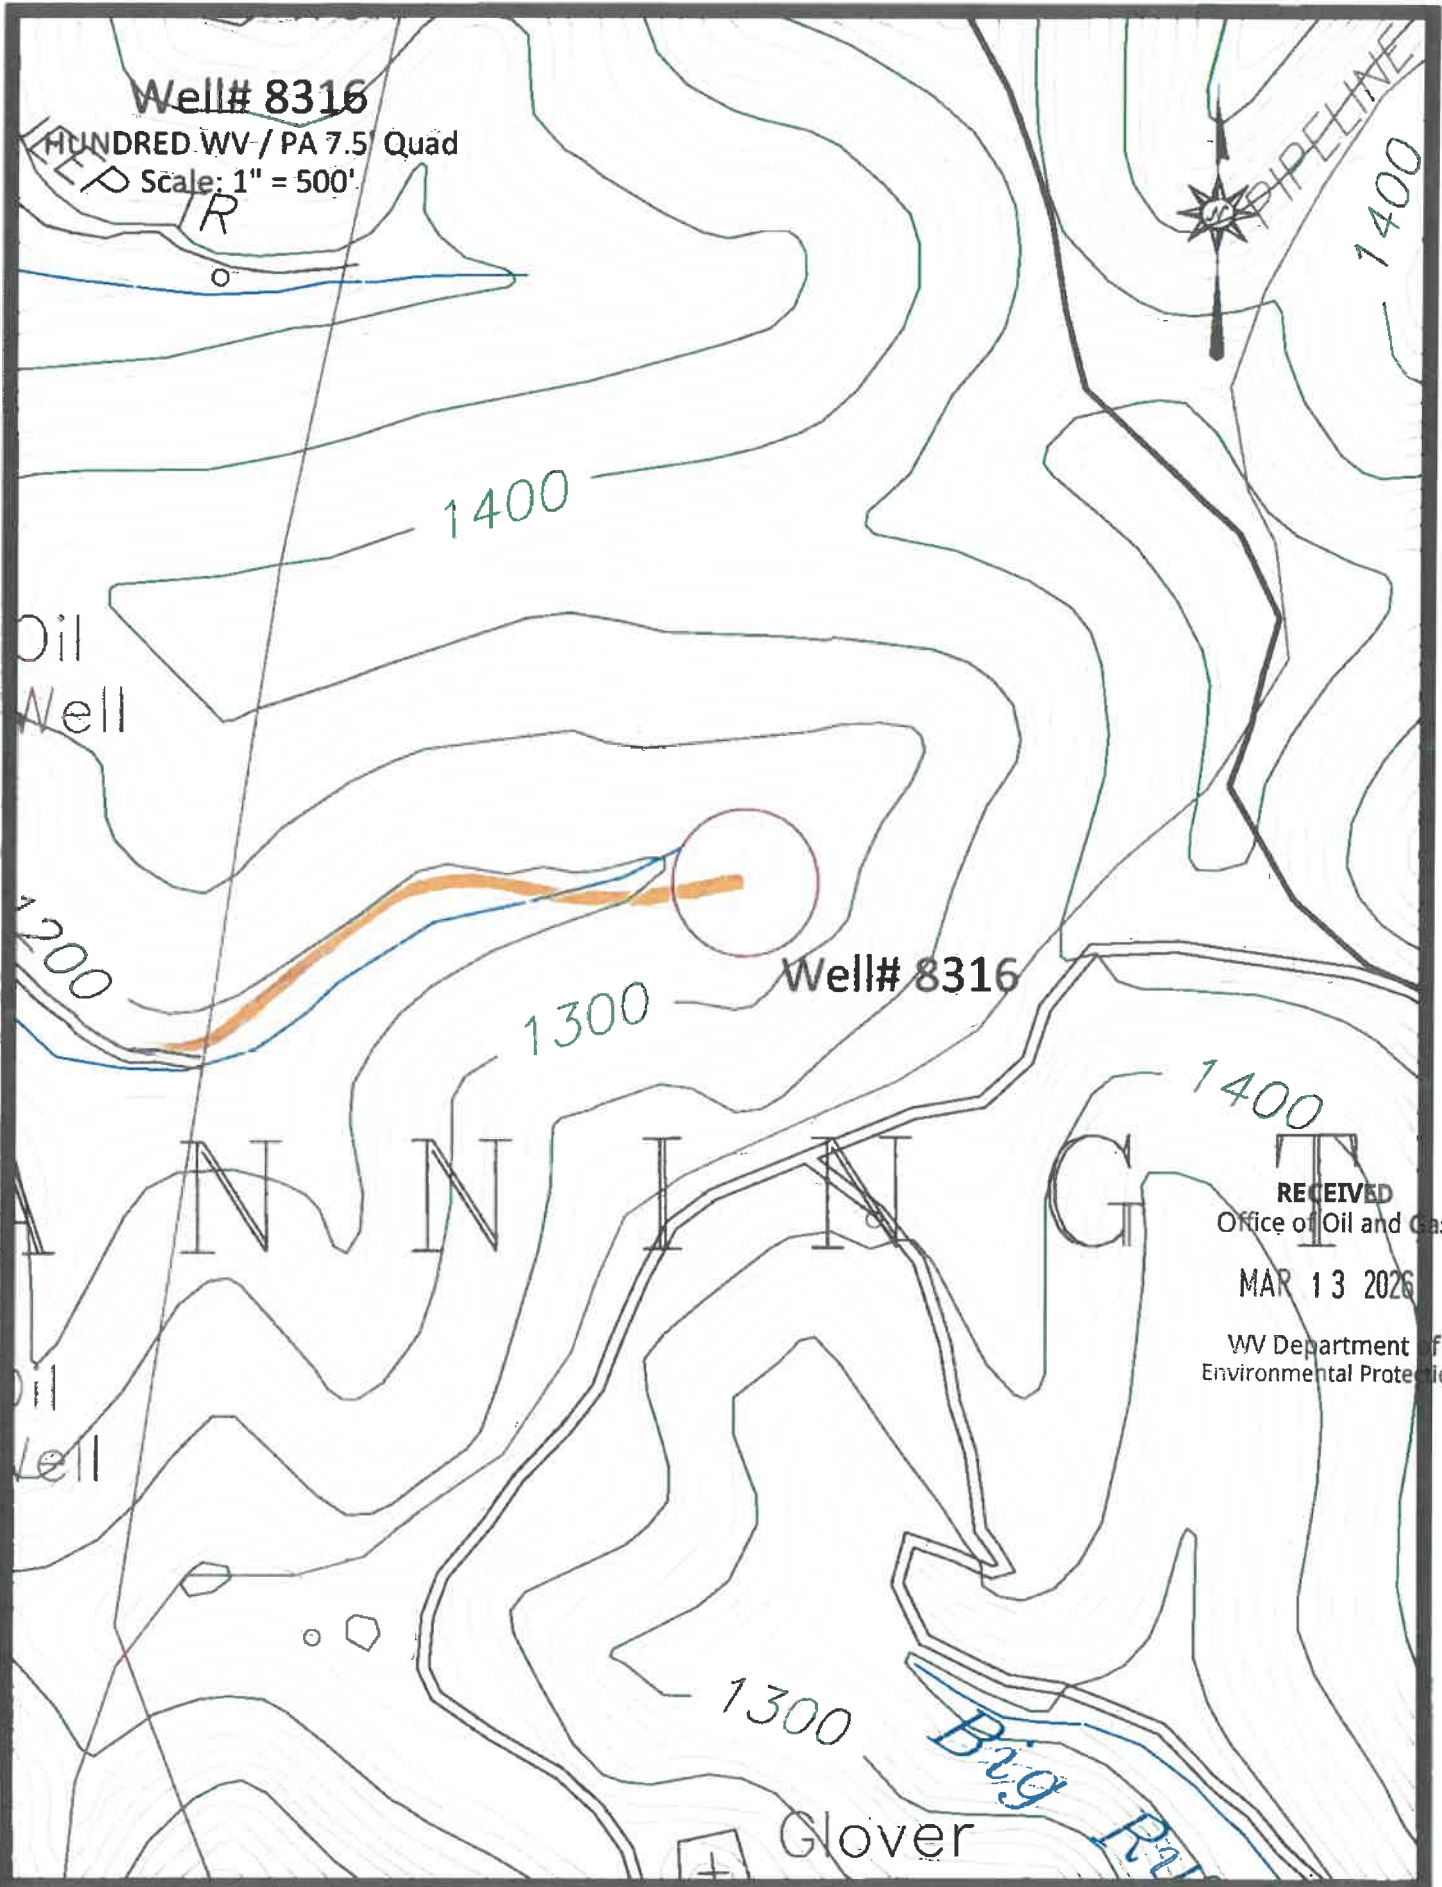

Well# 8316


HUNDRED WV / PA 7.5' Quad

Scale: 1" = 500'

RECEIVED  
Office of Oil and Gas  
MAR 13 2026  
WV Department of  
Environmental Protection

 Access Road

05/01/2026

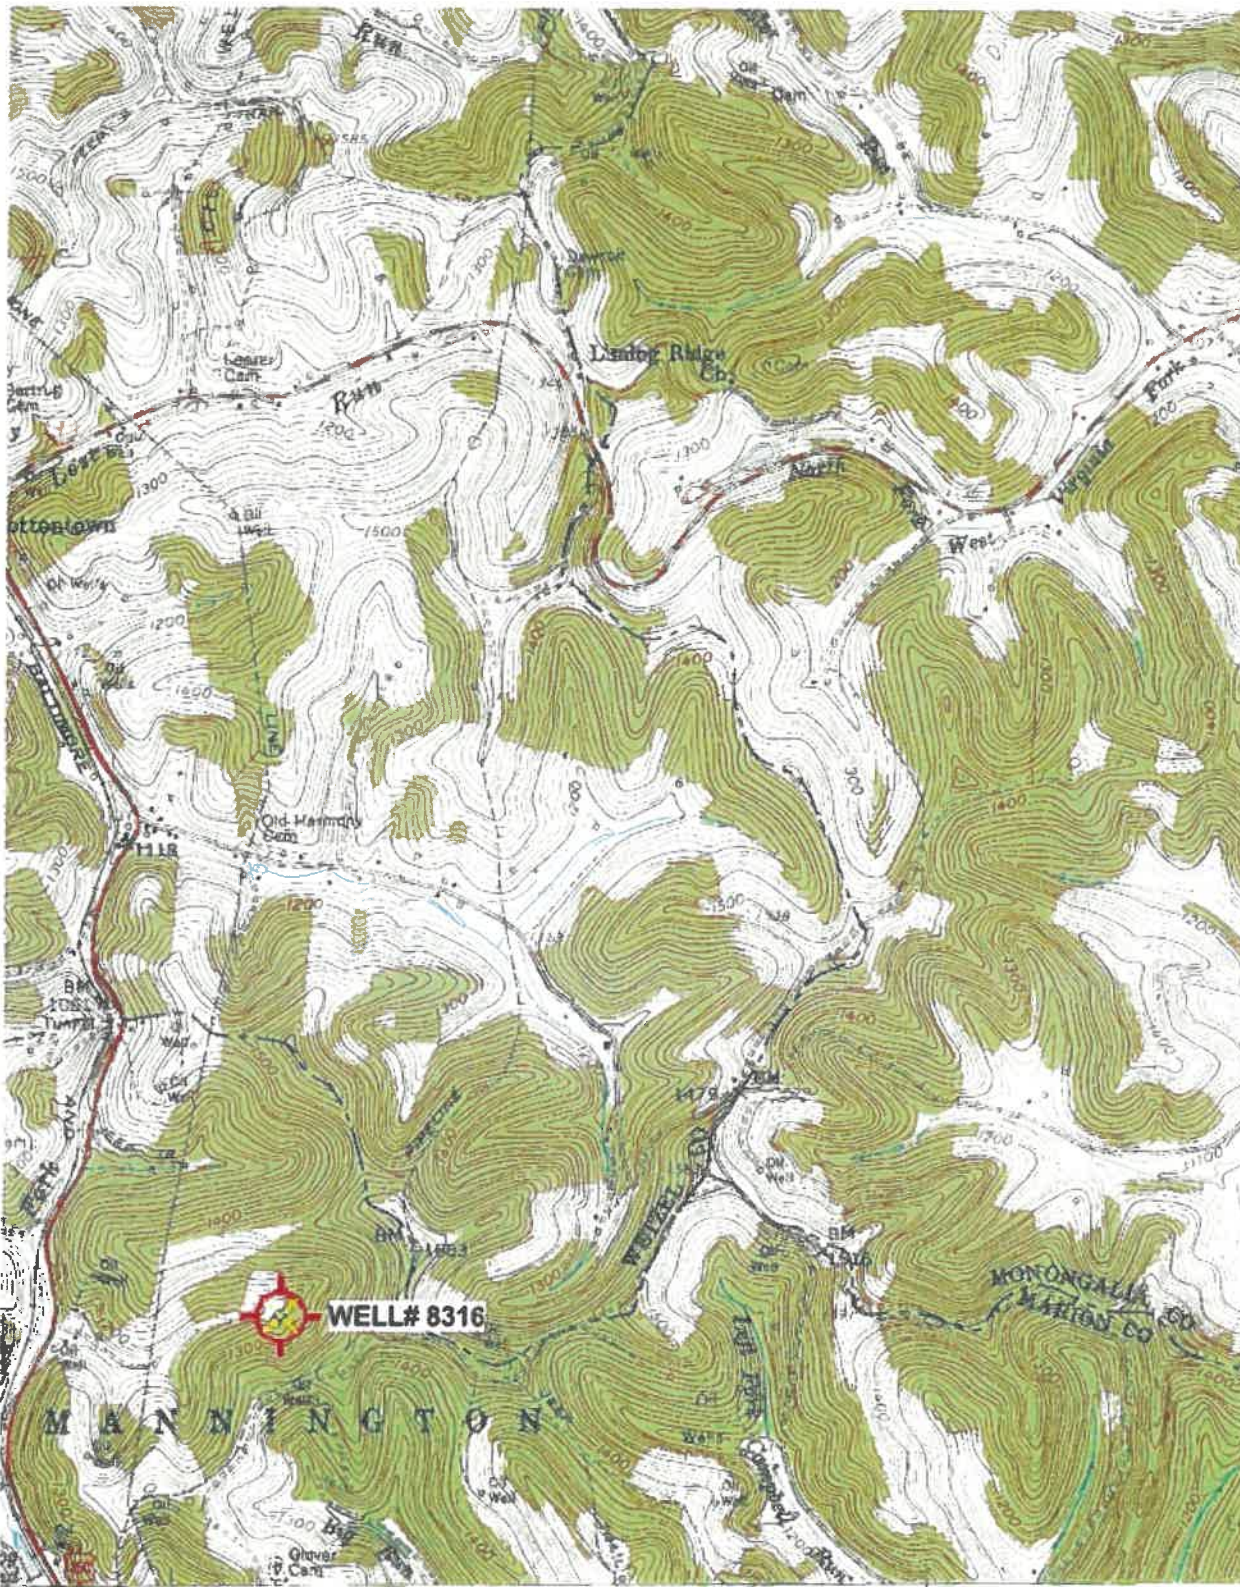

4291  
40'  
4289  
N 40°08'34"

120 000 FEET  
(PA) RECEIVED  
Office of Oil and Gas  
MAR 13 2026  
WV Department of  
Environmental Protection

25' 250 000 FEET (PA) 51

1 MILE  
00 FEET  
TER

ROAD CLASSIFICATION  
Heavy duty ——— Light-duty - - - -  
Medium duty ——— Unimproved dirt - - - -  
U S Route State Route



QUADRANGLE LOCATION

HUNDRED, W. VA. - PA.  
NW/4 MANNINGTON 15' QUADRANGLE  
N 3937.5 - W 8022.5 / 7.5

'Hundred; WV, PA' Scale: 1" = 0.379Mi 610Mt 2,000Ft, 1 Mi = 2.640", 1 cm = 240Mt

05/01/2026

(MANNINGTON)  
555 III SE

WW-7  
8-30-06



West Virginia Department of Environmental Protection  
Office of Oil and Gas

**WELL LOCATION FORM: GPS**

API: 47-049-00304 WELL NO.: 8316

FARM NAME: ROBERT N. CAMPBELL

RESPONSIBLE PARTY NAME: WEST VIRGINIA LAND RESOURCES INC.

COUNTY: MARION DISTRICT: MANNINGTON

QUADRANGLE: HUNDRED WV, PA

SURFACE OWNER: RENEE E. CAMPBELL

ROYALTY OWNER: \_\_\_\_\_

UTM GPS NORTHING: 4,387,207 m

UTM GPS EASTING: 550,445 m GPS ELEVATION: 378 m

The Responsible Party named above has chosen to submit GPS coordinates in lieu of preparing a new well location plat for a plugging permit or assigned API number on the above well. The Office of Oil and Gas will not accept GPS coordinates that do not meet the following requirements:

1. Datum: NAD 1983, Zone: 17 North, Coordinate Units: meters, Altitude: height above mean sea level (MSL) \_\_\_\_\_ meters.
2. Accuracy to Datum 3.05 meters
3. Data Collection Method:

Survey grade GPS  : Post Processed Differential \_\_\_\_\_  
Real-Time Differential

Mapping Grade GPS \_\_\_\_\_ : Post Processed Differential \_\_\_\_\_  
Real-Time Differential \_\_\_\_\_

**RECEIVED**  
Office of Oil and Gas

MAR 13 2026

WV Department of  
Environmental Protection

4. Letter size copy of the topography map showing the well location.

I the undersigned, hereby certify this data is correct to the best of my knowledge and belief and shows all the information required by law and the regulations issued and prescribed by the Office of Oil and Gas.

Signature

PS 2026

Title

JANUARY 15, 2026

Date

05/01/2026