

1:250 000 FEET (PA.)

1 MILE
7000 FEET
1.0 METER

ROAD CLASSIFICATION

Heavy duty	—	Light duty	- - -
Medium-duty	- · - · -	Unimproved dirt	- · - · -
U. S. Route	—	State Route	—


RECEIVED
Office of Oil and Gas
MAR 17 2026
WV Department of
Environmental Protection



HUNDRED, W. VA.—PA.
NW/4 MANNINGTON 15' QUADRANGLE
N 3937.5 — W 8022.5/7.5

'Hundred', W. VA. Scale: 1" = 0.379Mi 610Mi 2,000Ft, 1 Mi = 2.640", 1 cm = 240Mi

05/01/2026

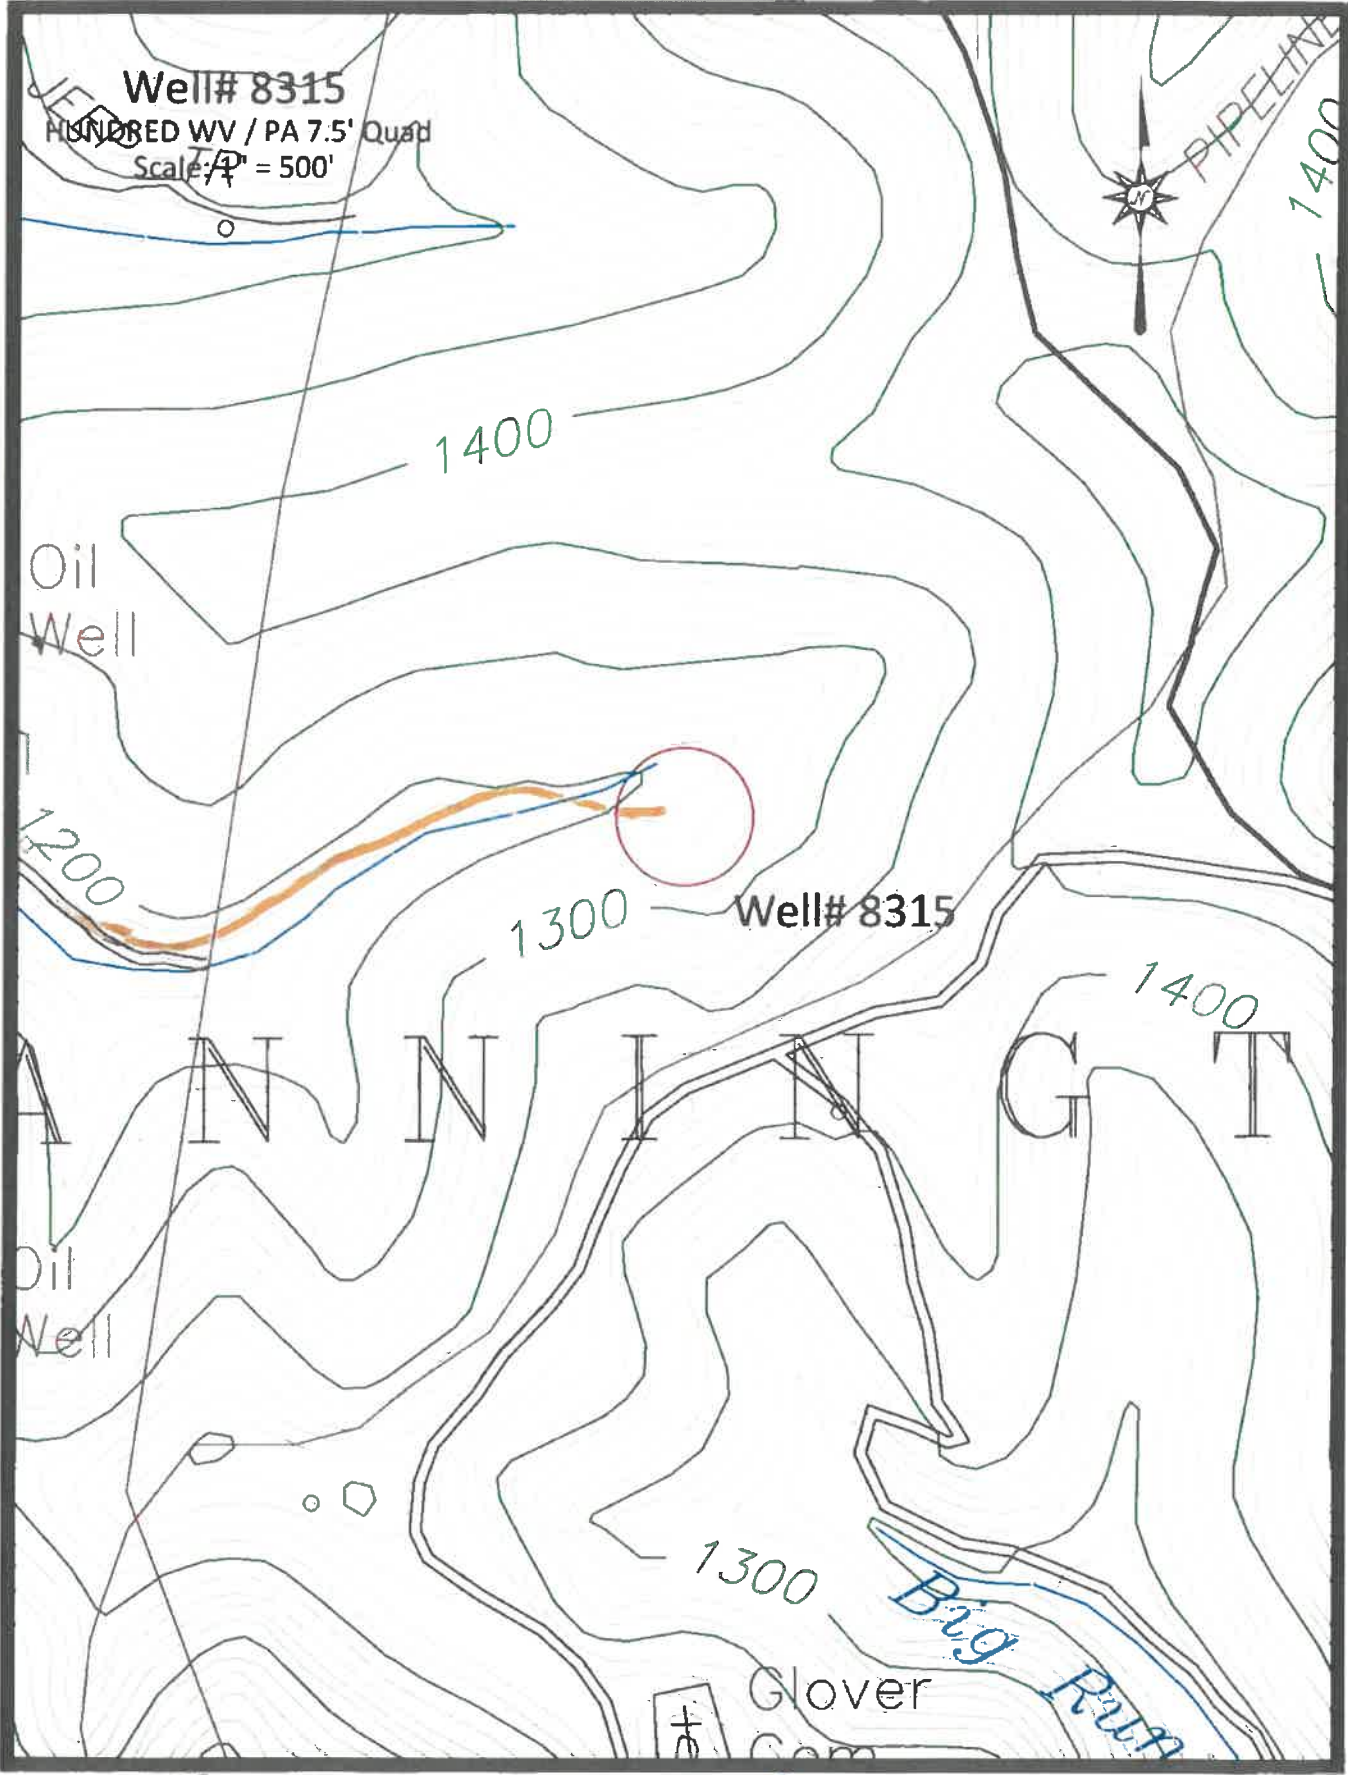

Well# 8315

HUNDRED WV / PA 7.5' Quad

Scale: 1" = 500'



PIPELINE

1400

Oil Well

1200

1300

Well# 8315

1400

A N N N I I I G T

Oil Well

1300

Big Run

Glover Camp


RECEIVED
Office of Oil and Gas

MAR 17 2026

Department of

— Access Road

05/01/2026

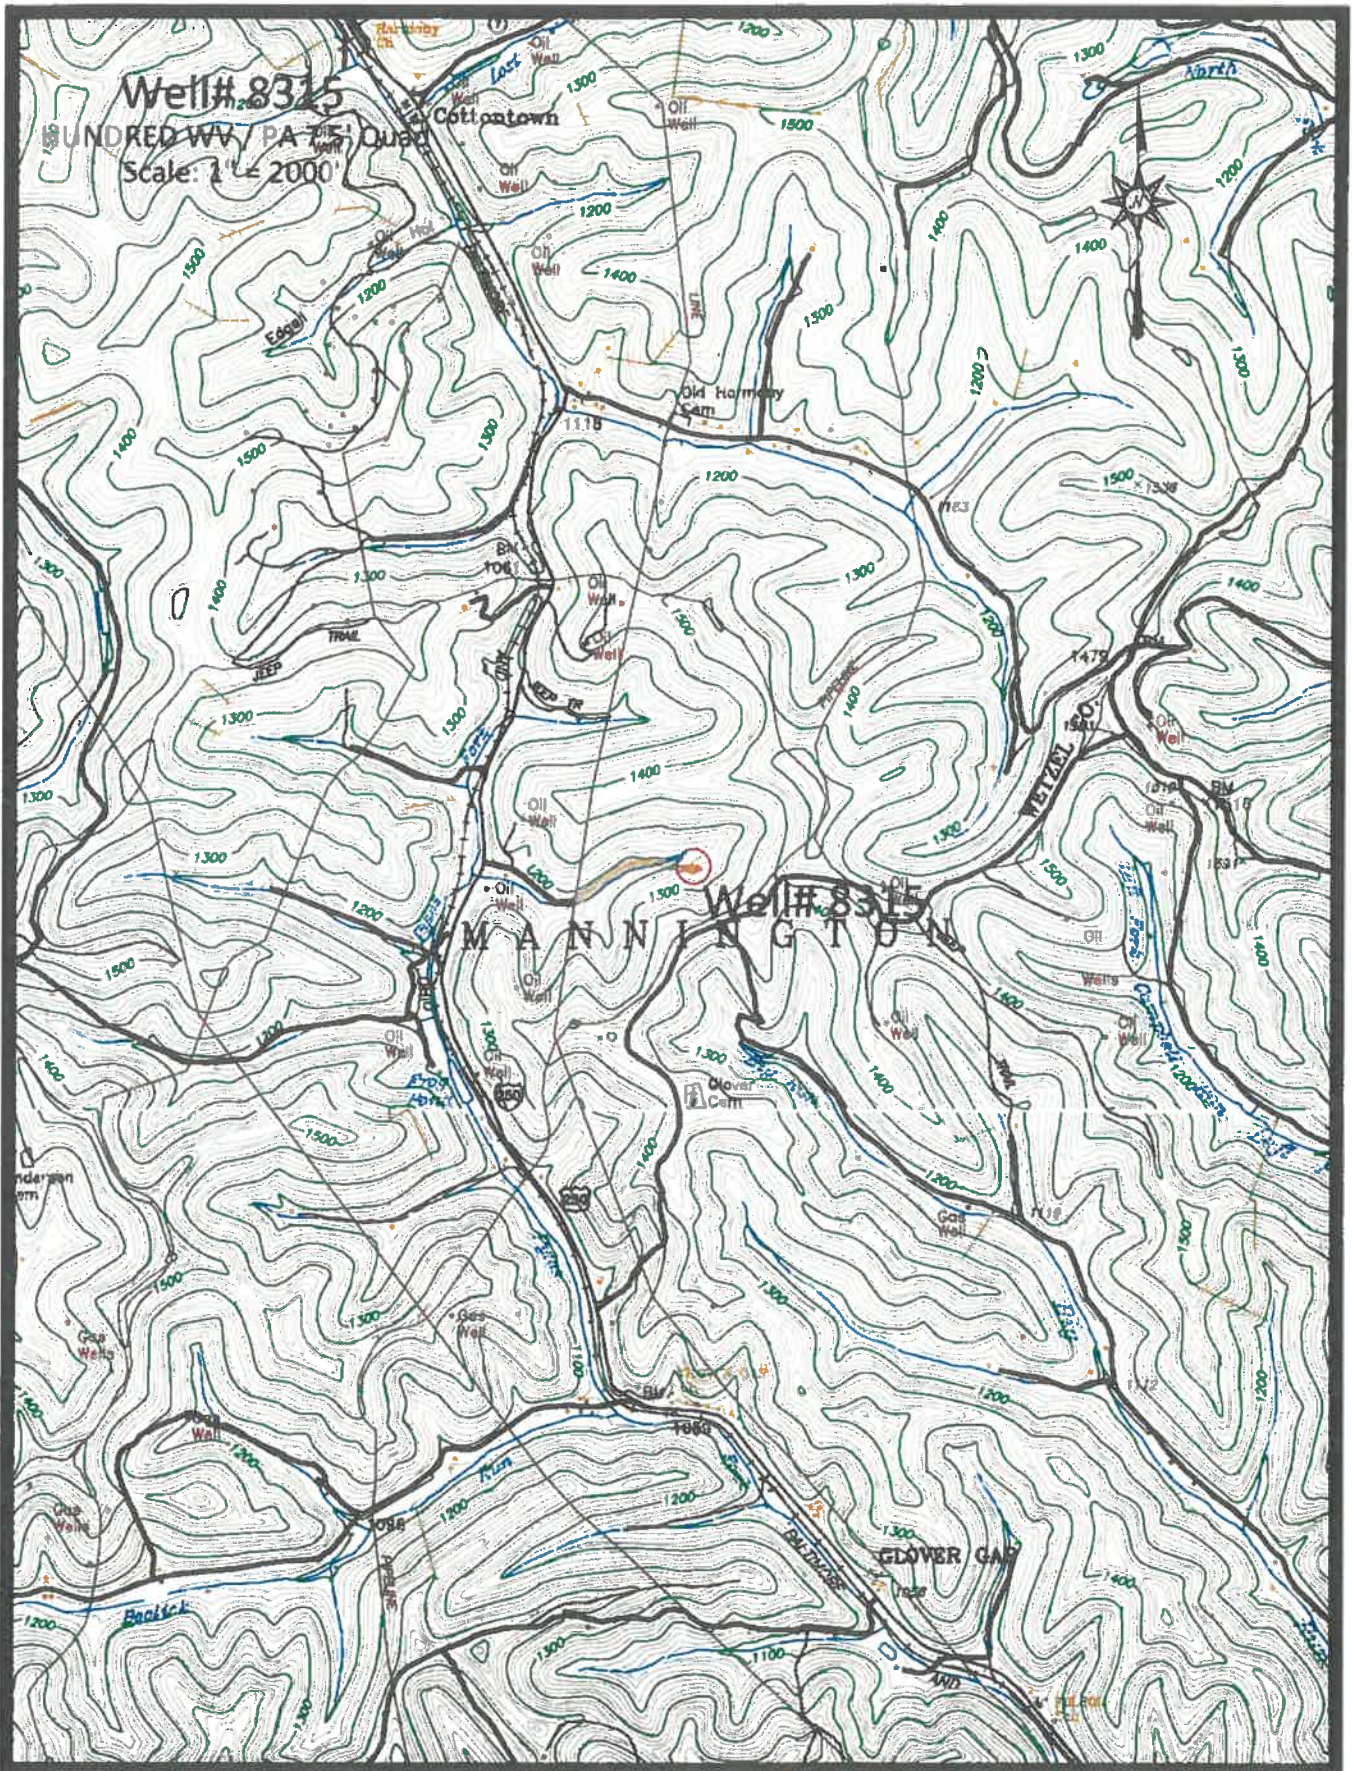

RECEIVED
 Office of Oil and Gas

— Access Road

MAR 17 2026

05/01/2026

WV Department of
 Environmental Protection

WW-7
8-30-06



West Virginia Department of Environmental Protection
Office of Oil and Gas

WELL LOCATION FORM: GPS

API: 47-049-00305 WELL NO.: 8315

FARM NAME: ROBERT N. CAMPBELL

RESPONSIBLE PARTY NAME: WEST VIRGINIA LAND RESOURCES INC.

COUNTY: MARION DISTRICT: MANNINGTON

QUADRANGLE: HUNDRED WV, PA

SURFACE OWNER: RENEE E. CAMPBELL

ROYALTY OWNER: _____

UTM GPS NORTHING: 4,387,188 m

UTM GPS EASTING: 550,416 m GPS ELEVATION: 378 m

The Responsible Party named above has chosen to submit GPS coordinates in lieu of preparing a new well location plat for a plugging permit or assigned API number on the above well. The Office of Oil and Gas will not accept GPS coordinates that do not meet the following requirements:

1. Datum: NAD 1983, Zone: 17 North, Coordinate Units: meters, Altitude: height above mean sea level (MSL) – meters.
2. Accuracy to Datum – 3.05 meters
3. Data Collection Method:

Survey grade GPS : Post Processed Differential _____

Real-Time Differential

Mapping Grade GPS _____ : Post Processed Differential _____

Real-Time Differential _____

4. Letter size copy of the topography map showing the well location.

I the undersigned, hereby certify this data is correct to the best of my knowledge and belief and shows all the information required by law and the regulations issued and prescribed by the Office of Oil and Gas.

Signature

PS 2002

Title

JANUARY 15, 2026

Date

RECEIVED
Office of Oil and Gas

MAR 17 2026

05/01/2026