WW-7	
8-30-06	
West Virginia Department of Environmental Protection	
Office of Oil and Gas	
WELL LOCATION FORM: GPS	
_{API:} 47-049-00445	_ WELL NO.: 5090
FARM NAME: Mary C. Tetrick	
RESPONSIBLE PARTY NAME: Peoples Gas WV, LLC	
	DISTRICT: Lincoln
QUADRANGLE: Shinnston	
SURFACE OWNER: Gary & Cindy	Eagle
ROYALTY OWNER: Tetrick heirs	
UTM GPS NORTHING: 4369343.00	
UTM GPS EASTING: 560788.26	GPS ELEVATION: N/A 970'

The Responsible Party named above has chosen to submit GPS coordinates in lieu of preparing a new well location plat for a plugging permit or assigned API number on the above well. The Office of Oil and Gas will not accept GPS coordinates that do not meet the following requirements:

- Datum: NAD 1983, Zone: 17 North, Coordinate Units: meters, Altitude: 1. height above mean sea level (MSL) - meters.
- 2. Accuracy to Datum - 3.05 meters
- Data Collection Method: 3.

Survey grade GPS ____: Post Processed Differential _____

Real-Time Differential _____ Mapping Grade GPS <u>_____</u>: Post Processed Differential _____


Real-Time Differential

4. Letter size copy of the topography map showing the well location. I the undersigned, hereby certify this data is correct to the best of my knowledge and belief and shows all the information required by law and the regulations issued and prescribed by the Office of Oil and Gas.

Land ManagerS/9/2021TitleDate OUG LOUGLAS Signature

08/13/2021


47-049-00445P

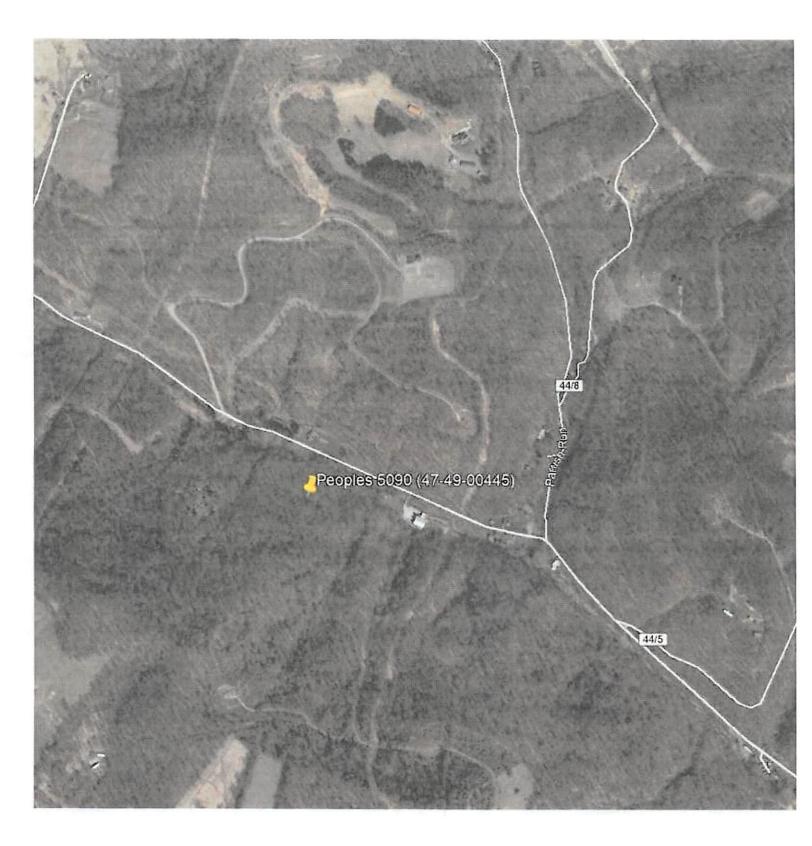

08/13/2021

47-049-00445P

Peoples 5090 topo

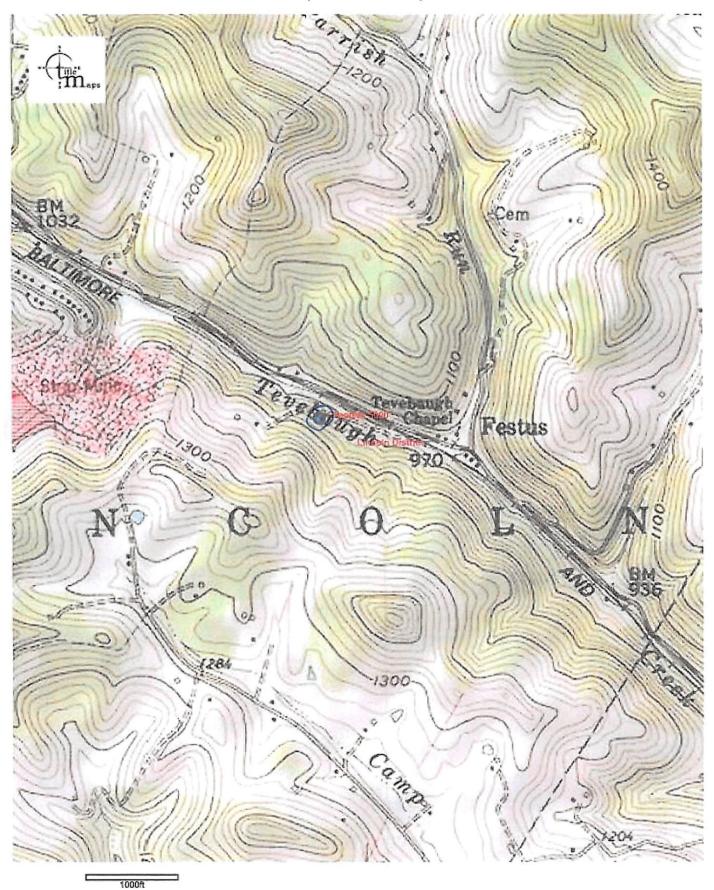

Approximate Scale 1:12,000

06/17/2021 - 04:01:07 PM

Disclaimer: The map information shown is from various sources including but not imited to tax maps and state and foderal agency web siles. The map information does not represent and should not be relied upon as a land survey or legal depiction of the property or information shown. This Maps PCC oper 750 April for accuracy or correctness of the map with match shown horizon.