

WW-7
8-30-06



RECEIVED
Office of Oil and Gas
JAN 29 2024
WV Department of
Environmental Protection

West Virginia Department of Environmental Protection
Office of Oil and Gas
WELL LOCATION FORM: GPS

API: 4704900580 WELL NO.: Talkington AO 4

FARM NAME: A.O. Talkington

RESPONSIBLE PARTY NAME: Diversified Production, LLC

COUNTY: Marion DISTRICT: Lincoln

QUADRANGLE: Mannington 7.5'

SURFACE OWNER: Wiley G. Orr

ROYALTY OWNER: John Talkington, Mark Talkington, Virginia Straight, WV Minerals Inc.

UTM GPS NORTHING: 4376867.36

UTM GPS EASTING: 559895.64 GPS ELEVATION: 1229.94'

The Responsible Party named above has chosen to submit GPS coordinates in lieu of preparing a new well location plat for a plugging permit or assigned API number on the above well. The Office of Oil and Gas will not accept GPS coordinates that do not meet the following requirements:

1. Datum: NAD 1983, Zone: 17 North, Coordinate Units: meters, Altitude: height above mean sea level (MSL) – meters.
2. Accuracy to Datum – 3.05 meters
3. Data Collection Method:

Survey grade GPS ____: Post Processed Differential ____

Real-Time Differential ____

Mapping Grade GPS X: Post Processed Differential X

Real-Time Differential ____

4. **Letter size copy of the topography map showing the well location.**

I the undersigned, hereby certify this data is correct to the best of my knowledge and belief and shows all the information required by law and the regulations issued and prescribed by the Office of Oil and Gas.

Signature

Chris Veazey - Permitting Supervisor

Title

01/24/24

Date





Diversified Gas & Oil Corporation
100 Diversified Way
Pikeville KY, 41051

47-049-00580
Plugging Map

Legend

- Well
- Access Road
- ▨ Pits
- ▭ Pad
- Public Roads

RECEIVED
Office of Oil and Gas
JAN 29 2024
WV Department of
Environmental Protection

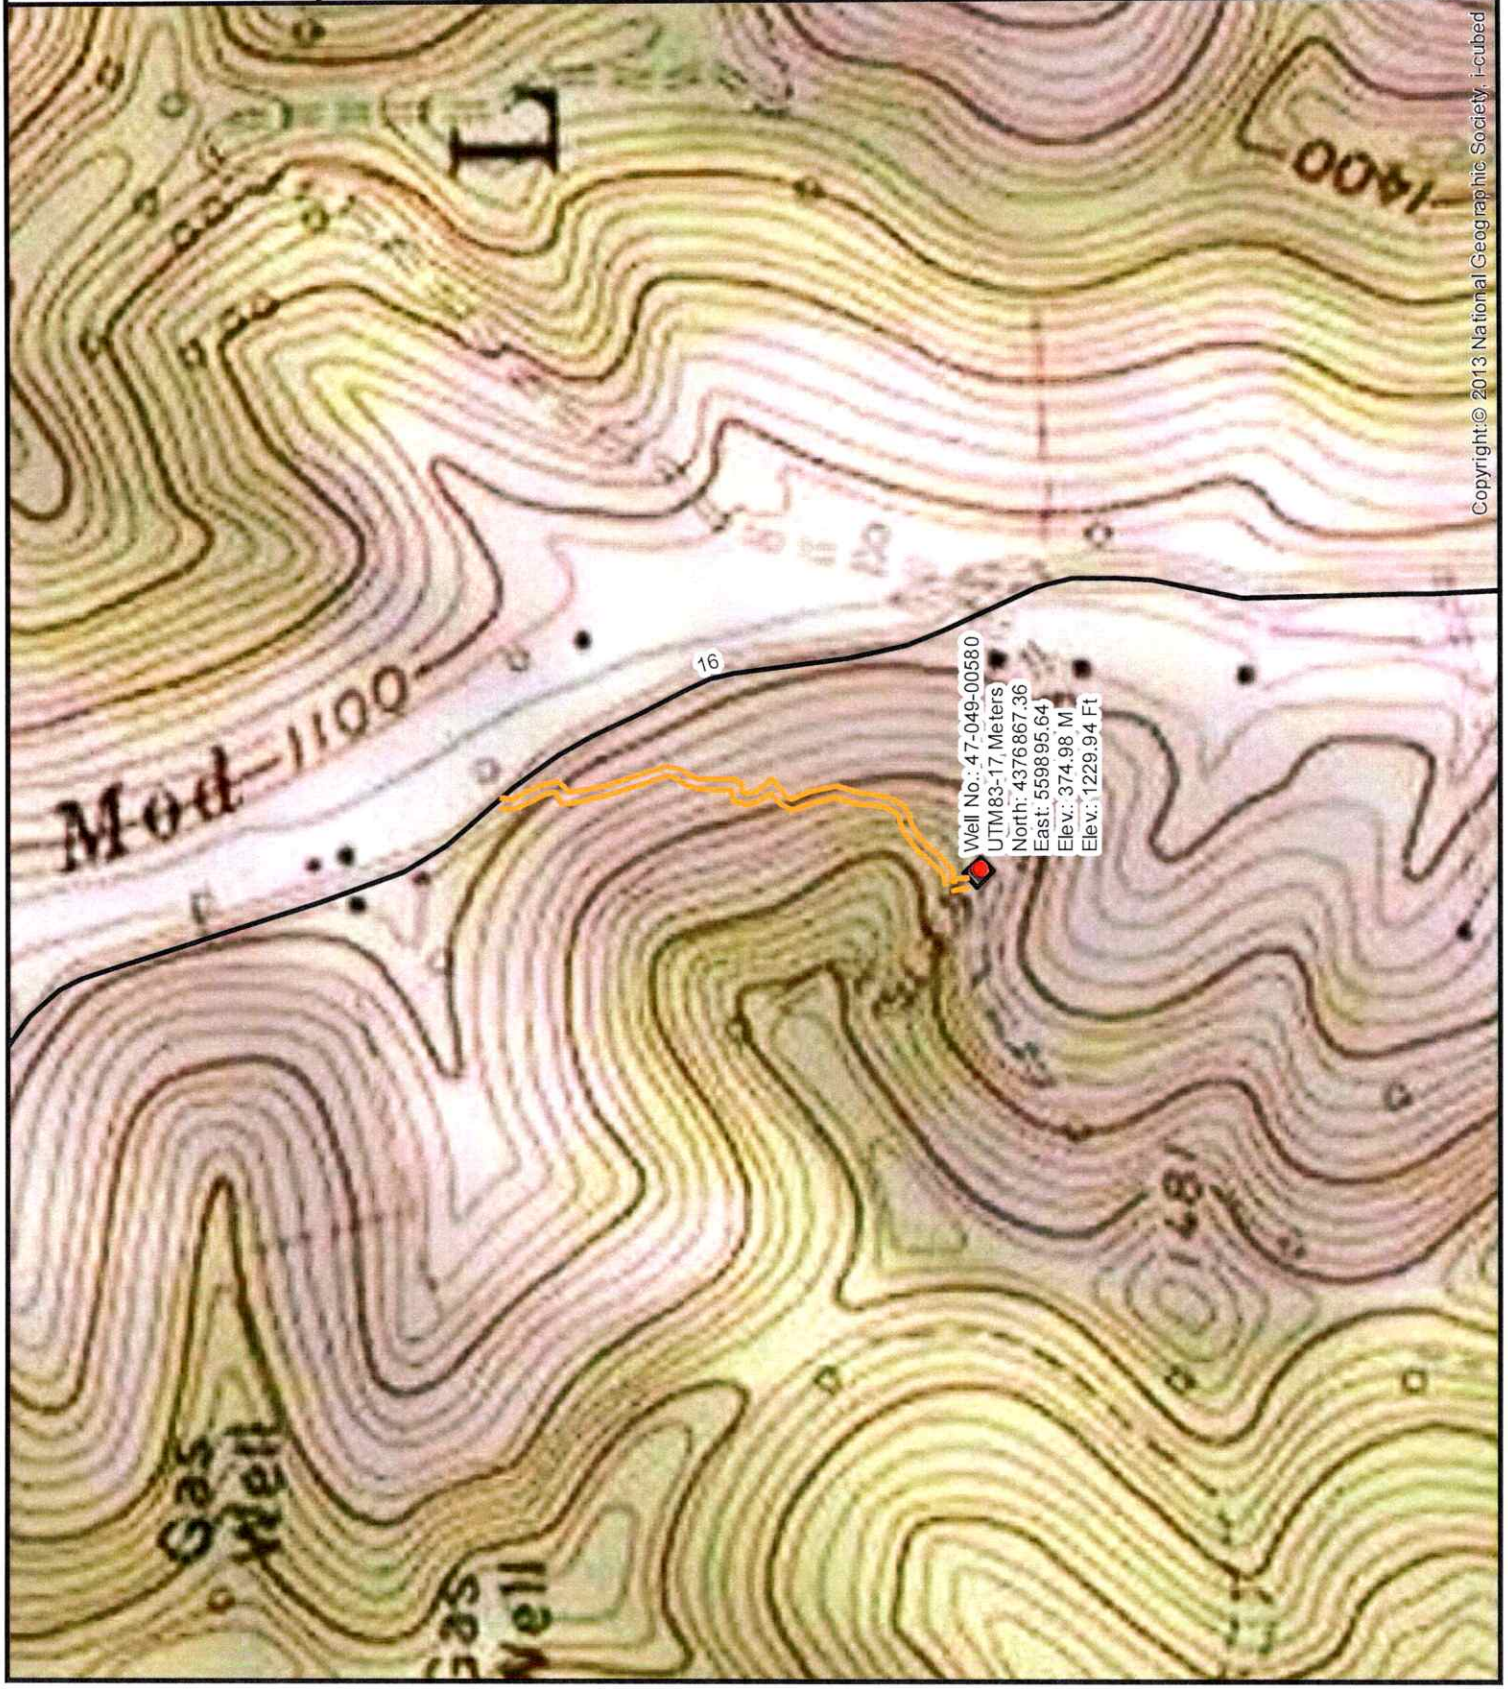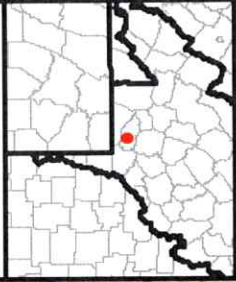

Well No.: 47-049-00580
UTM 183-17, Meters
North: 4376867.36
East: 559895.64
Elev.: 374.98 M
Elev.: 1229.94 Ft