


LATITUDE 39° 37' 30"

LONGITUDE 88° 17' 30"

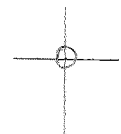

7'5 OGIS topo location

7.5' loc 1.235 15' loc _____
0.89 v (calc.) _____


ny _____

WELL LOCATION MAP

File No. 049 - 0594

Quad MANNINGTON 7 1/2'
County MARION
District PAW PAW

Ele. 1530 ± (top)

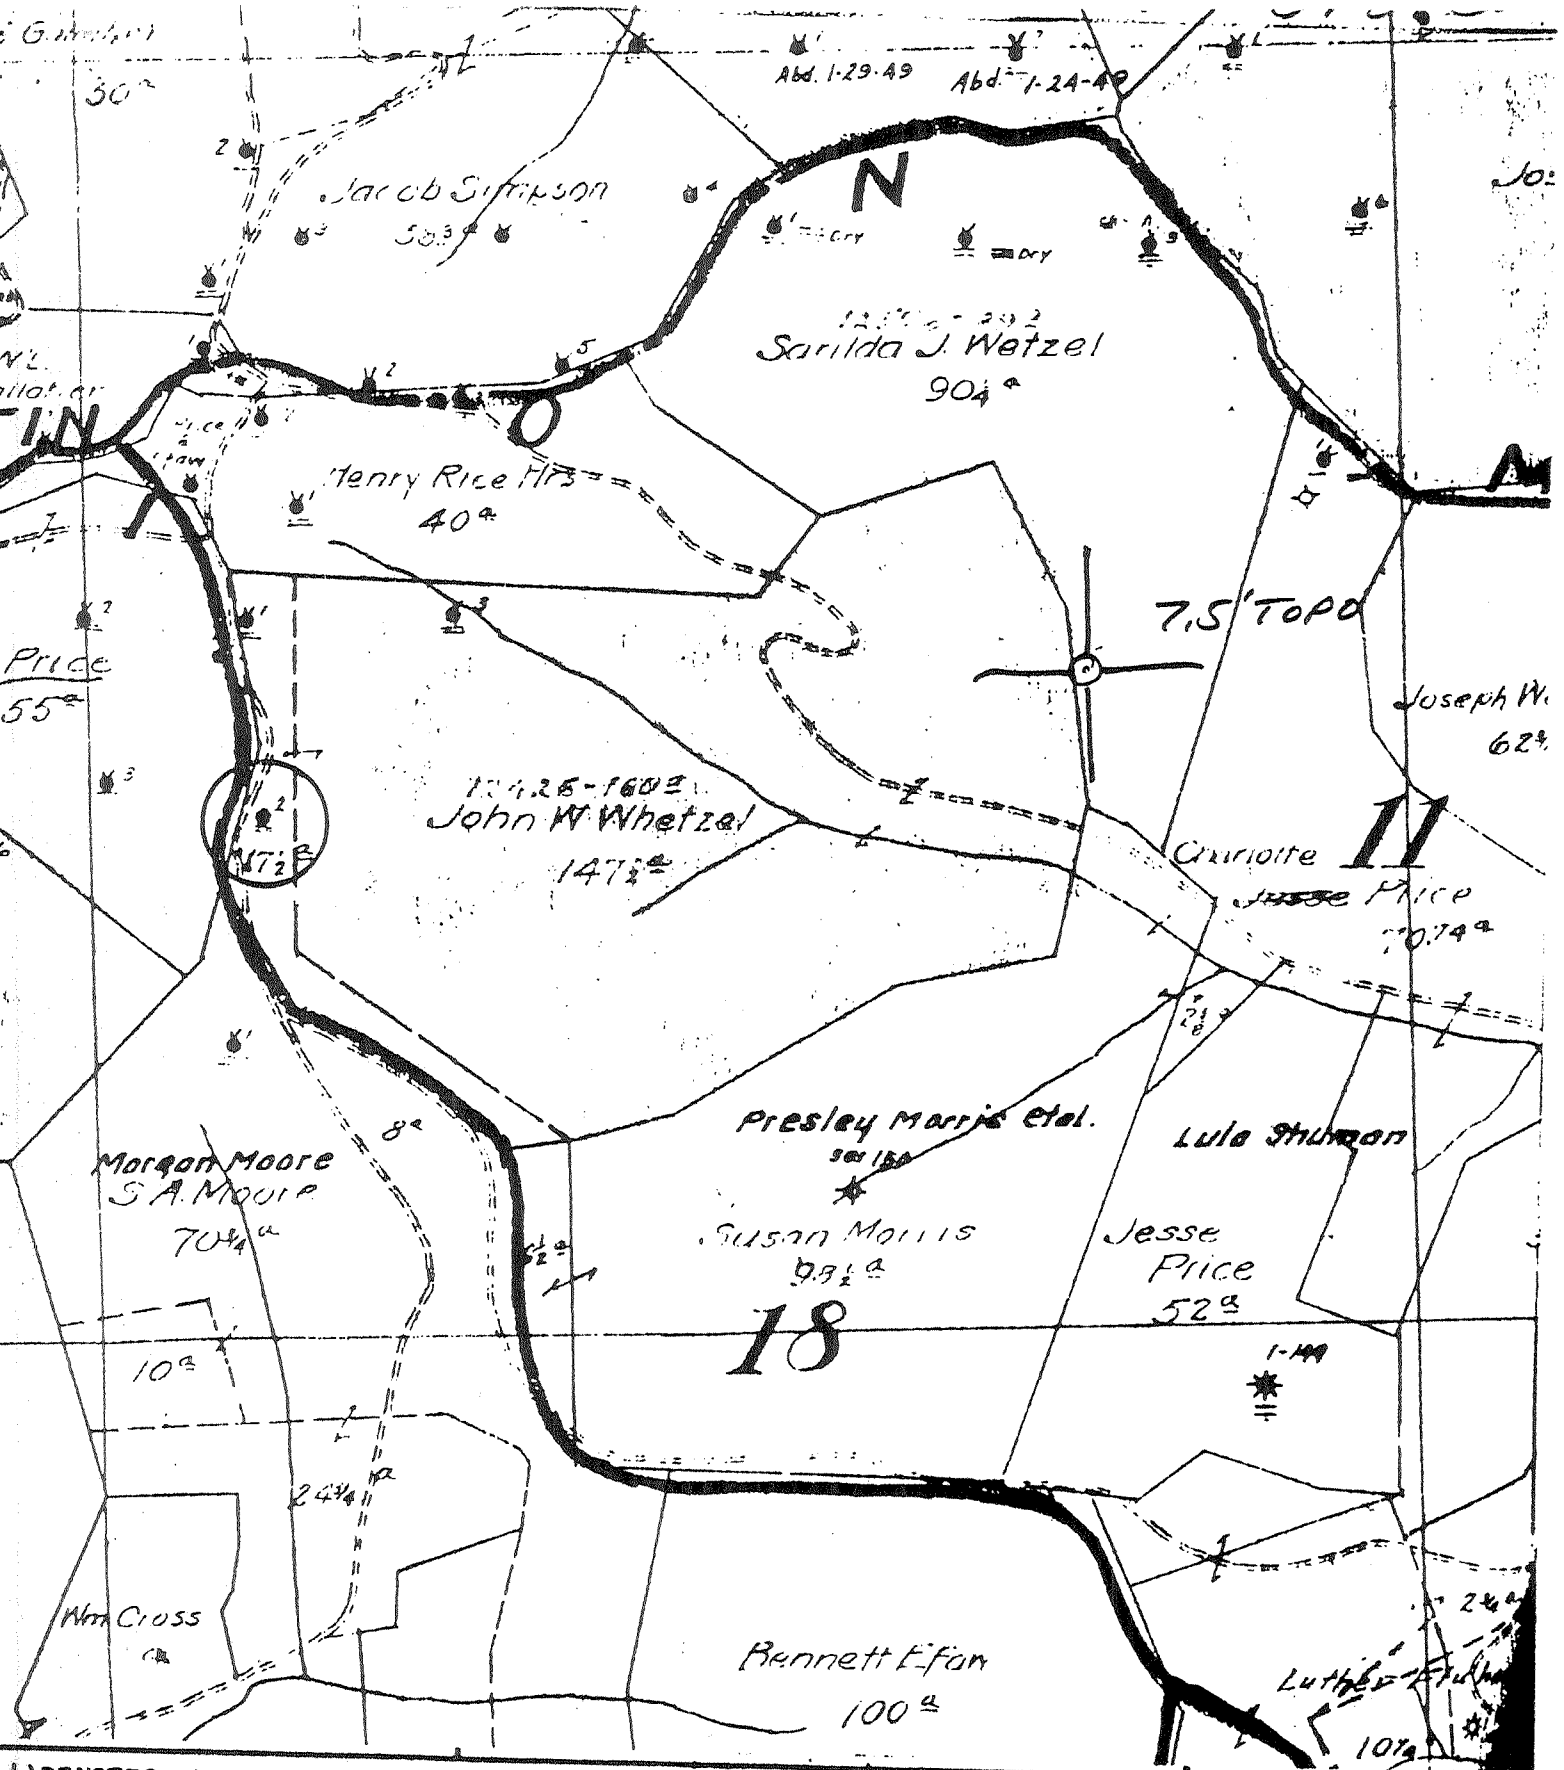

+ DENOTES LOCATION OF WELL ON UNITED STATES TOPOGRAPHIC MAPS

FORM IV-6 (8-78)

161E N10 E 18



STATE OF WEST VIRGINIA
DEPARTMENT OF MINES
OIL AND GAS DIVISION

DATE 1-24- 19 79
OPERATOR'S WELL NO 2
API WELL NO. 47-149-0594
STATE COUNTY PERMIT

WELL TYPE: OIL GAS _____ LIQUID INJECTION _____ WASTE DISPOSAL _____
(IF "GAS", PRODUCTION _____ STORAGE _____ DEEP _____ SHALLOW _____)
LOCATION: ELEVATION _____ WATER SHED SUGAR RUN
DISTRICT PAW PAW COUNTY MARION
QUADRANGLE MANNINGTON 7.5'
SURFACE OWNER _____ ACREAGE _____
OIL & GAS ROYALTY OWNER _____ LEASE NO. _____ LEASE ACREAGE _____
PROPOSED WORK: DRILL _____ CONVERT _____ DRILL DEEPER _____ REDRILL _____ FRACTURE OR STIMULATE _____ PLUS OFF OLD FORMATION _____ PERFORATE NEW FORMATION _____ OTHER PHYSICAL CHANGE IN WELL (SPECIFY) _____

PLUS AND ABANDON _____ CLEAN OUT AND REPLUS _____
TARGET FORMATION _____ ESTIMATED DEPTH _____
WELL OPERATOR Pennzoil Company DESIGNATED AGENT James A. Crews
ADDRESS P. O. Box 1588 ADDRESS P. O. Box 1588
Parkersburg, WV 26101 Parkersburg, WV 26101

Wetzel
J. W. Whetzel - 2

No. 1

SOUTH PENN OIL COMPANY—COMPLETION

SERIAL NO. _____ FARM J. W. Wetzel WELL NO. 2
 ELEVATION _____ N. 11 S. _____ E. 18 W. _____
 LEASE NO. 12426 ACRES _____

WATERS OF _____
 DISTRICT Paw Paw COUNTY Marion STATE W. Va.
 DRILLING COMMENCED Apr. 8, 1897 COMPLETED June 24, 1897 DEPTH 3457

SANDS	TOP	BOTTOM	ELEV. TOP	CASING
Pgh. Coal	1216	1223		10" 336'
Big Dunkard	1738	1785		8 1/2" 1732'
Big Injun	2525	2670		6-5/8" 2228'
Fifty Foot	3112	3190		5-3/16" 2770'
Thirty Foot	2990	3005		4 1/4" 258'-11"
Stray	3381	3411		
Gordon	3423			

INITIAL PROD. _____ SAND Gordon DEPTH 3435

GAS TEST _____

SHOT NOV. 20, 1909 QUARTS 20 SAND Gordon DEPTH 3435

REMARKS _____

REPORTED BY METZ DISTRICT ABANDONED _____

47-049-0594