

4900605F

WW-7
5-02

West Virginia Department of Environmental Protection
Office of Oil & Gas

WELL LOCATION FORM: GPS

API: 47- 049 - 0605 WELL NO: No.10

FARM NAME: James Yost

RESPONSIBLE PARTY NAME: HG Energy, LLC

COUNTY: Marion DISTRICT: Paw Paw

QUADRANGLE: Mannington 7.5'

SURFACE OWNER: George & Joan Darrah et al.

ROYALTY OWNER: HG Energy LLC et al.

UTM GPS NORTHING: 4,383,561


UTM GPS EASTING: 564,352 GPS ELEVATION: 389 m. 1276 FT

The Responsible Party named above has chosen to submit GPS coordinates in lieu of preparing a new well location plat for a plugging permit on the above well. The Office of Oil & Gas will not accept GPS coordinates that do not meet the following requirements:

1. Datum: NAD 1983, Zone:17 North, Coordinate Units: meters, Altitude: height above mean sea level (MSL) - meters.
2. Accuracy to Datum - 3.05 meters
3. Data Collection Method:

Survey Grade GPS	<input type="checkbox"/>	Post Processed Differential	<input type="checkbox"/>
		Real-Time Differential	<input type="checkbox"/>
Mapping Grade GPS	<input checked="" type="checkbox"/>	Post Processed Differential	<input checked="" type="checkbox"/>
		Real-Time Differential	<input type="checkbox"/>

I the undersigned, hereby certify this data is correct to the best of my knowledge and belief and shows all the information required by law and the regulations issued and prescribed by the Office of Oil and Gas.


 Timothy P. Roush
Signature

Professional Surveyor
Title

July 3, 2013
Date

Received
AUG - 2 2013
Office of Oil and Gas
WV Dept. of Environmental Protection

SUBJECT WELL
James Yost No. 10
47-049-0605

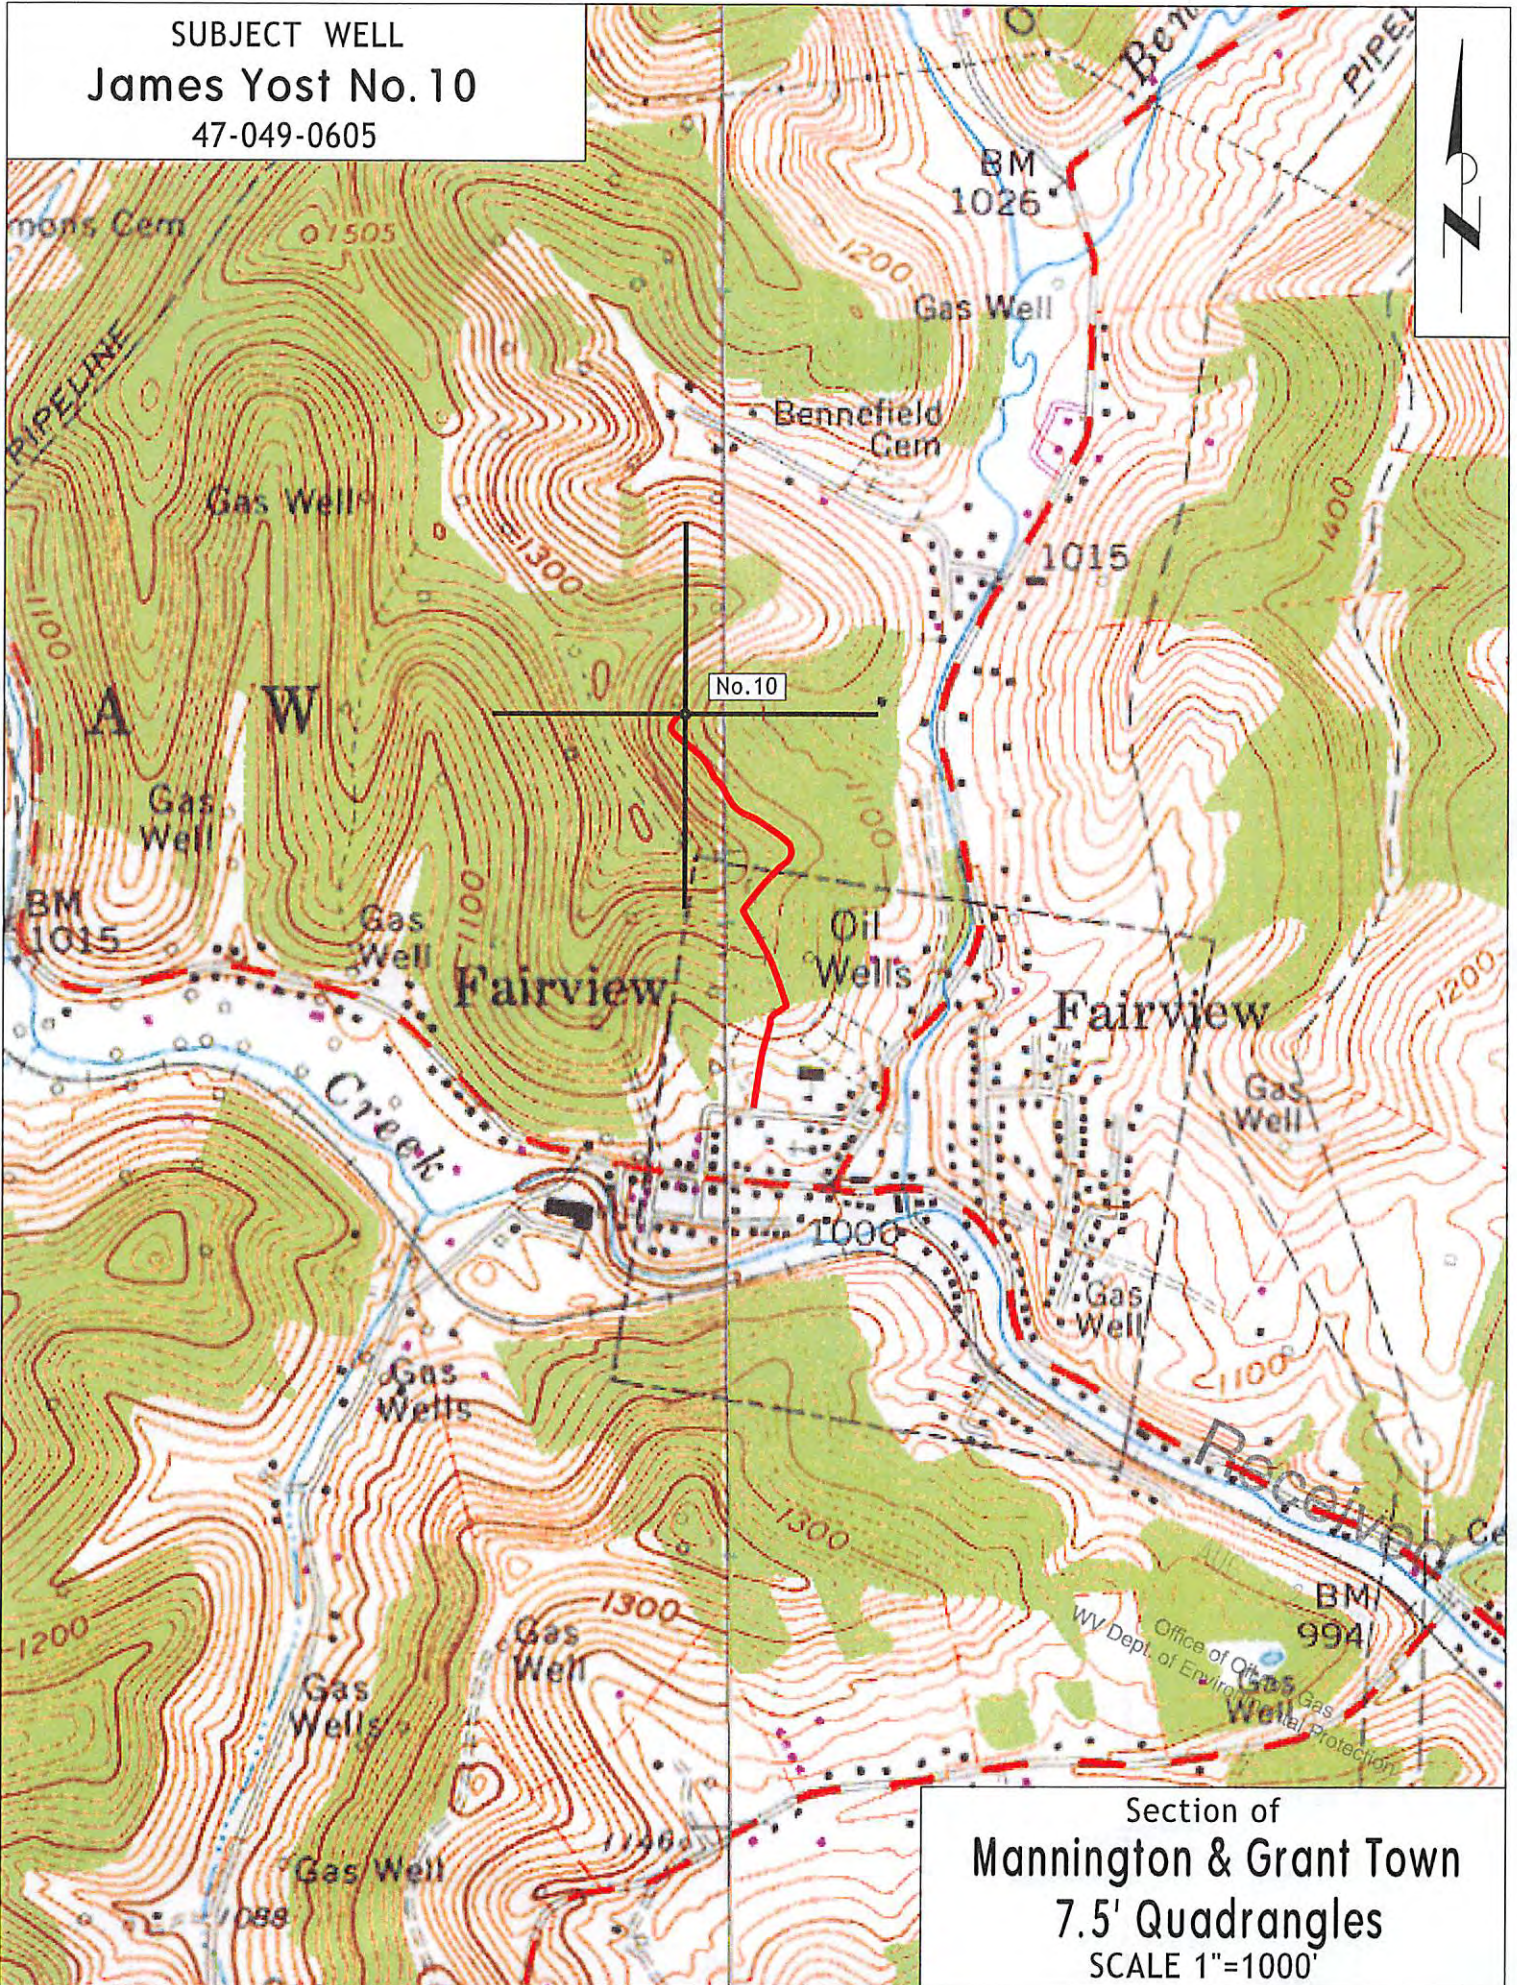

Section of
Mannington & Grant Town
7.5' Quadrangles
SCALE 1"=1000'