

Company	Hope Natural Gas Co.
Address	Clarksburg, W.Va.
Farm	J.J. Talkington
Tract	1 Acres 120 Lease No. 10530
Well (Farm) No.	1 Serial No. 1976
Elevation (Spirit Level)	1232
Quadrangle	Blacksville S.W.
County	Marion District Paw Paw
Engineer	W.M. Bowers
Engineer's Registration No.	900
File No.	Drawing No.
Date	Mar. 24, 1938 Scale 1"=40 P.

STATE OF WEST VIRGINIA
Department of Mines
OIL AND GAS DIVISION
CHAR LESTON


WELL LOCATION MAP
File No. MAR-186-a

Denotes location of well on United States Topographic Maps, scale 1 to 62,500, latitude and longitude lines being represented by border lines as shown.

Denotes one inch spaces on border line of original tracing.

GRANT TOWN QUADRANGLE
WEST VIRGINIA
7.5 MINUTE SERIES (TOPOGRAPHIC)
SW 4 BLACKSVILLE 15' QUADRANGLES

049-696

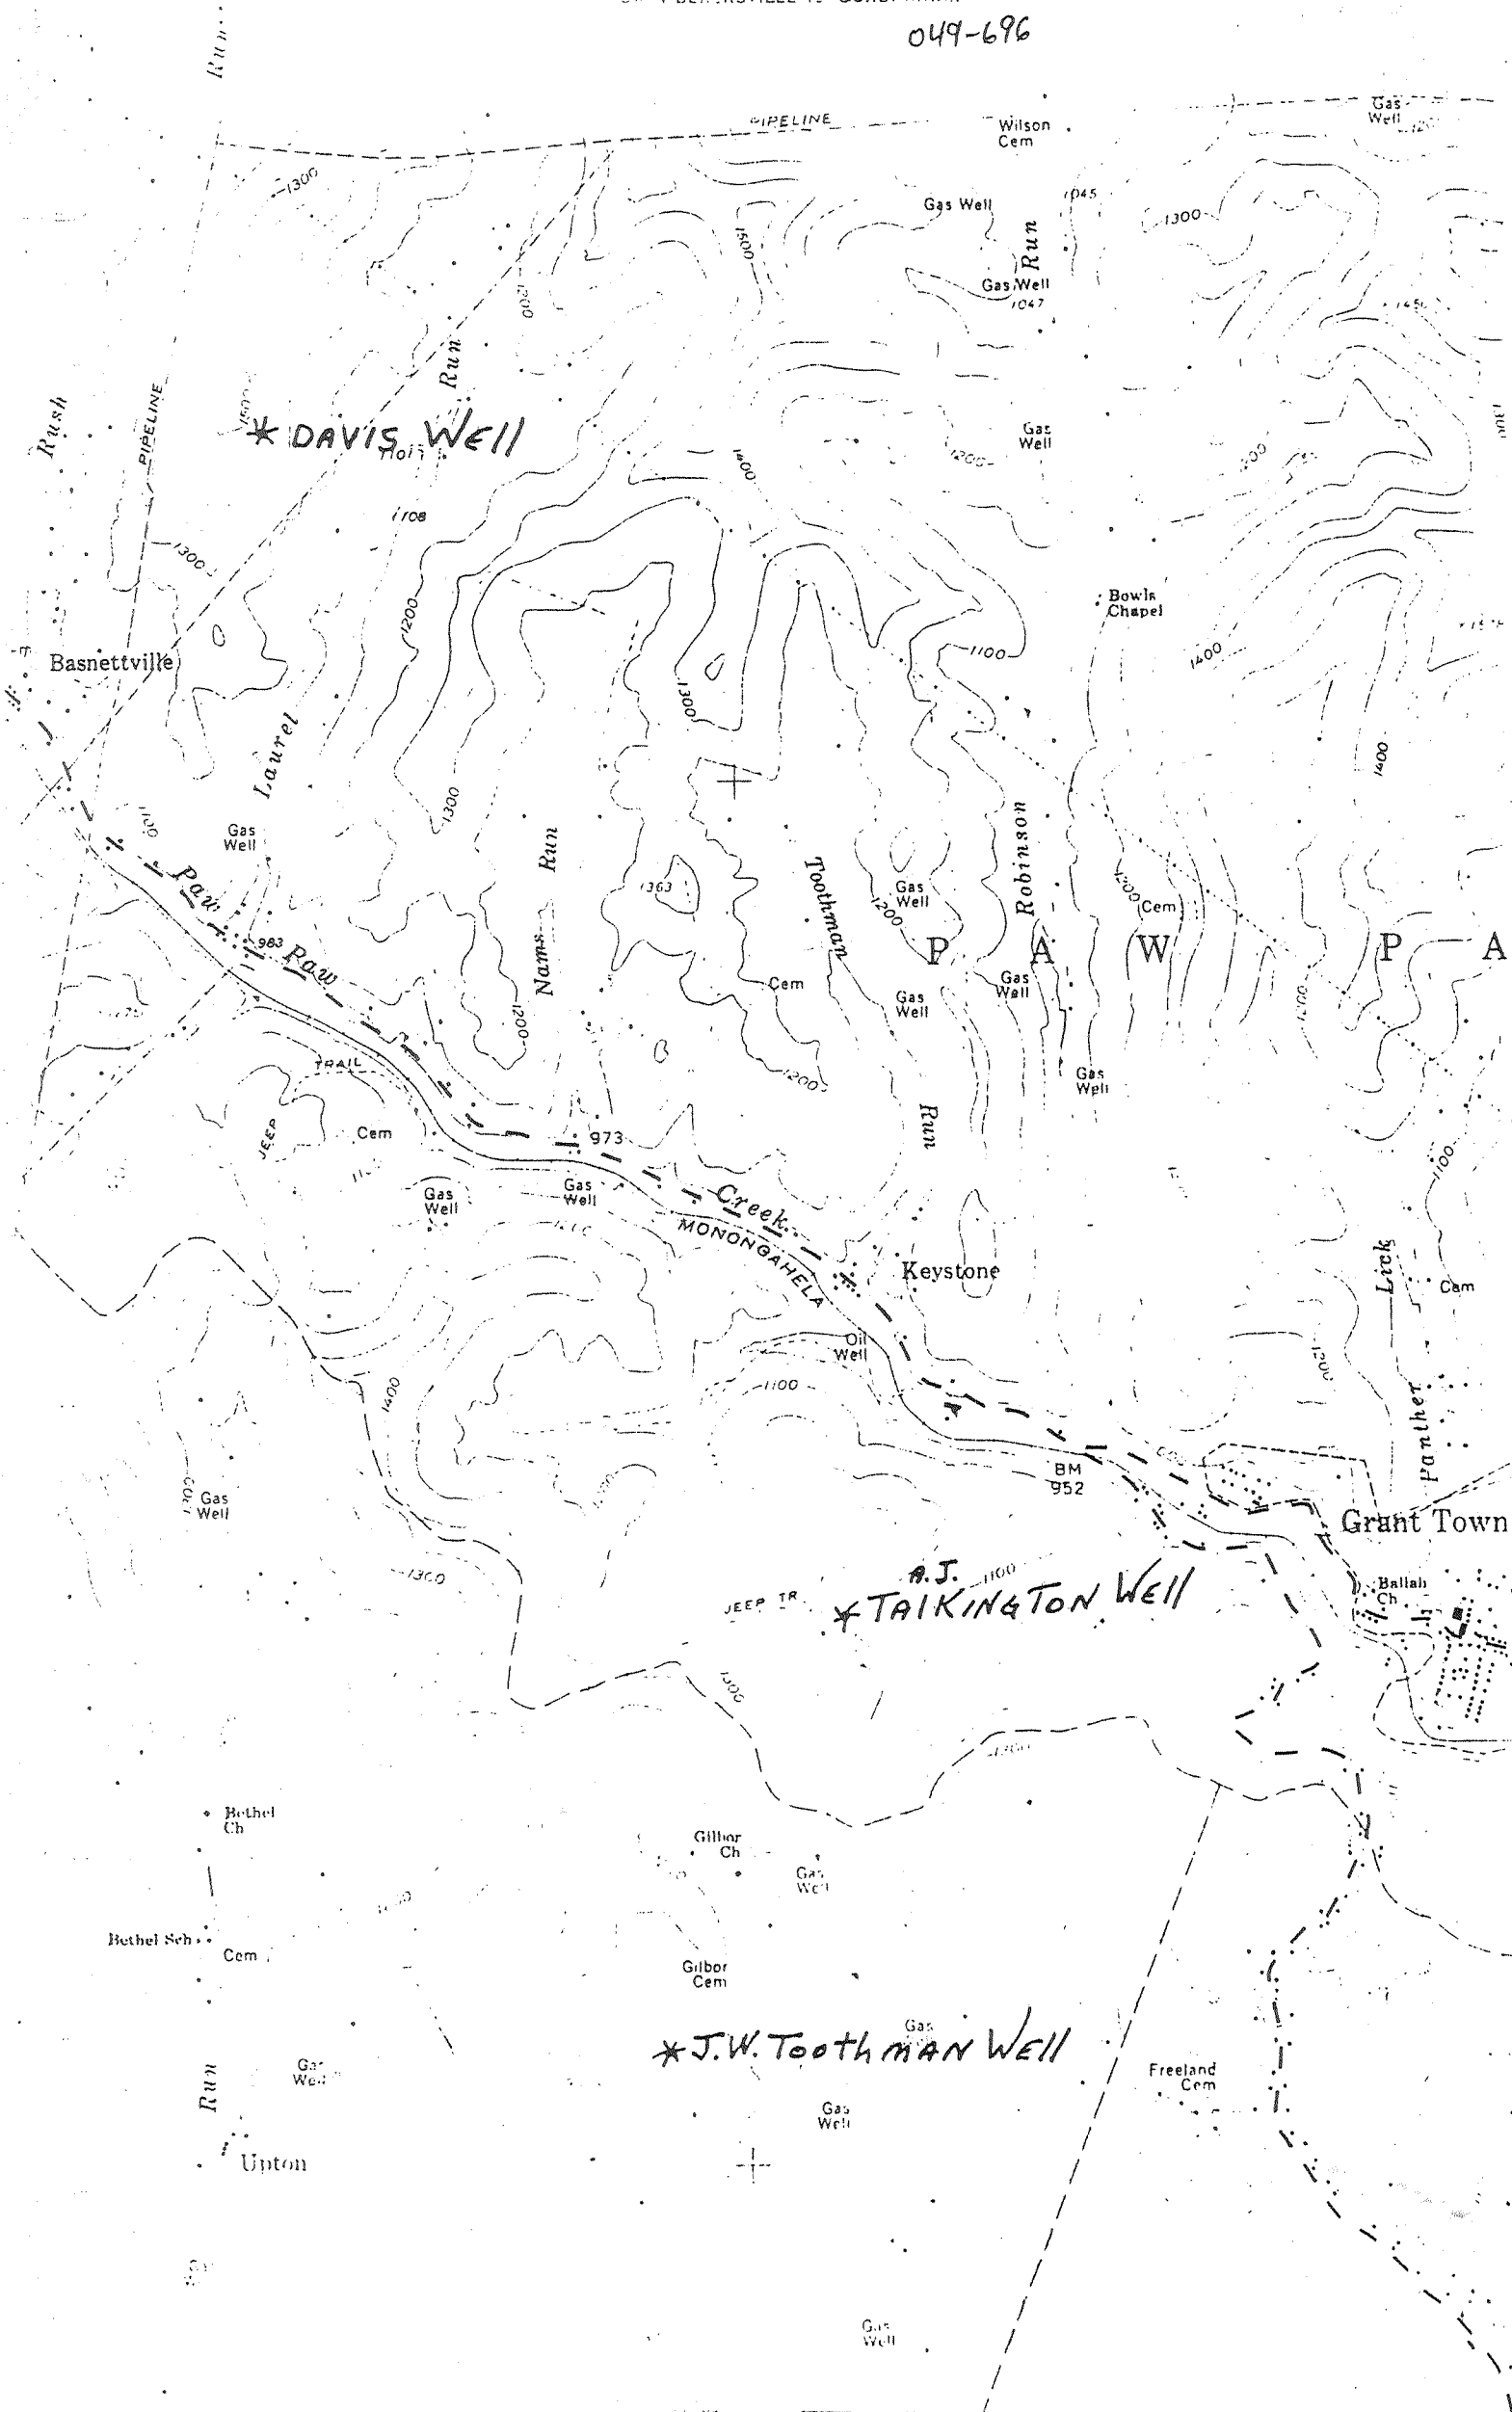

** DAVIS Well*

A.J. TALKINGTON Well

** J.W. ToOTHMAN Well*

Grant Town

Basnettville

Laurel Run

Nams Run

Toothman Run

Robinson Run

Creek MONONGAHELA

Keystone

Lick Panther

Bethel Ch

Bethel Sch

Gilbor Ch

Gilbor Cem

Upton

Freeland Cem

Ballah Ch

Wilson Cem

Bowlr Chapel

Cem

Cem

BM 952

Cem

Oil Well

Gas Well

Gas Well

Gas Well 1047

Gas Well

Gas Well

Run

Rush

PIPELINE

PIPELINE

TRAIL

Run

Gas Well

Well No. 1976

Name *W. J. Talkington*

Yearly Rental \$75.00 Dec 12-7-46
Lease No 10530 Acres 1.20

District *Paw-Paw*

Mid-Eastern Gas Co.

County -- Marion, W. Va.

Burton, W. Va, 26564

INFORMATION	TOP	BOTTOM	GAS AT	CASING
Pittsburgh Coal	545	554		10" 582'
Lunkard Sand	928	1110		8 1/2" 1488'
Salt Sand	1320	1600		Pulled 588'
Maxon Sand	1665	1685		6" 1811'
Injun Sand	1852	1875	1909	5" 2817'
Squaw Sand	1980	2010	1970	Pulled 202'
Berea Sand	2080	2120		P 2806'
Gantz Sand	2344	2410		
Fifty Ft. Sand	2438	2538		
Stray Sand	2714	2733		
Gordon Sand	2762	2793		
Fourth Sand	2798	2812		
Fifth Sand	2902	2929	2922-27	
Total		2026		
Rock Pressure 65	Volume 15,061			
ROYALTY PAID TO		ROYALTY		DATE DUE
\$50.00	to Almira J. Talkington, R.I, Rivesville, W. Va.,	2/3	\$75.00 Yearly	12-7-46 1-6-48
25.00	to Maurice Lester Talkington, Turlock, California	1/3		
Original lease dated August 18, 1922 on record S.B. 446 page 171. Reduced to \$75.00				
200,000 cu ft. Free - agreement made in Sept 1946 + 1/2 of all over 200,000 Mr. Sinden was to pay.				
<i>20 acres</i>				