


4704900949f

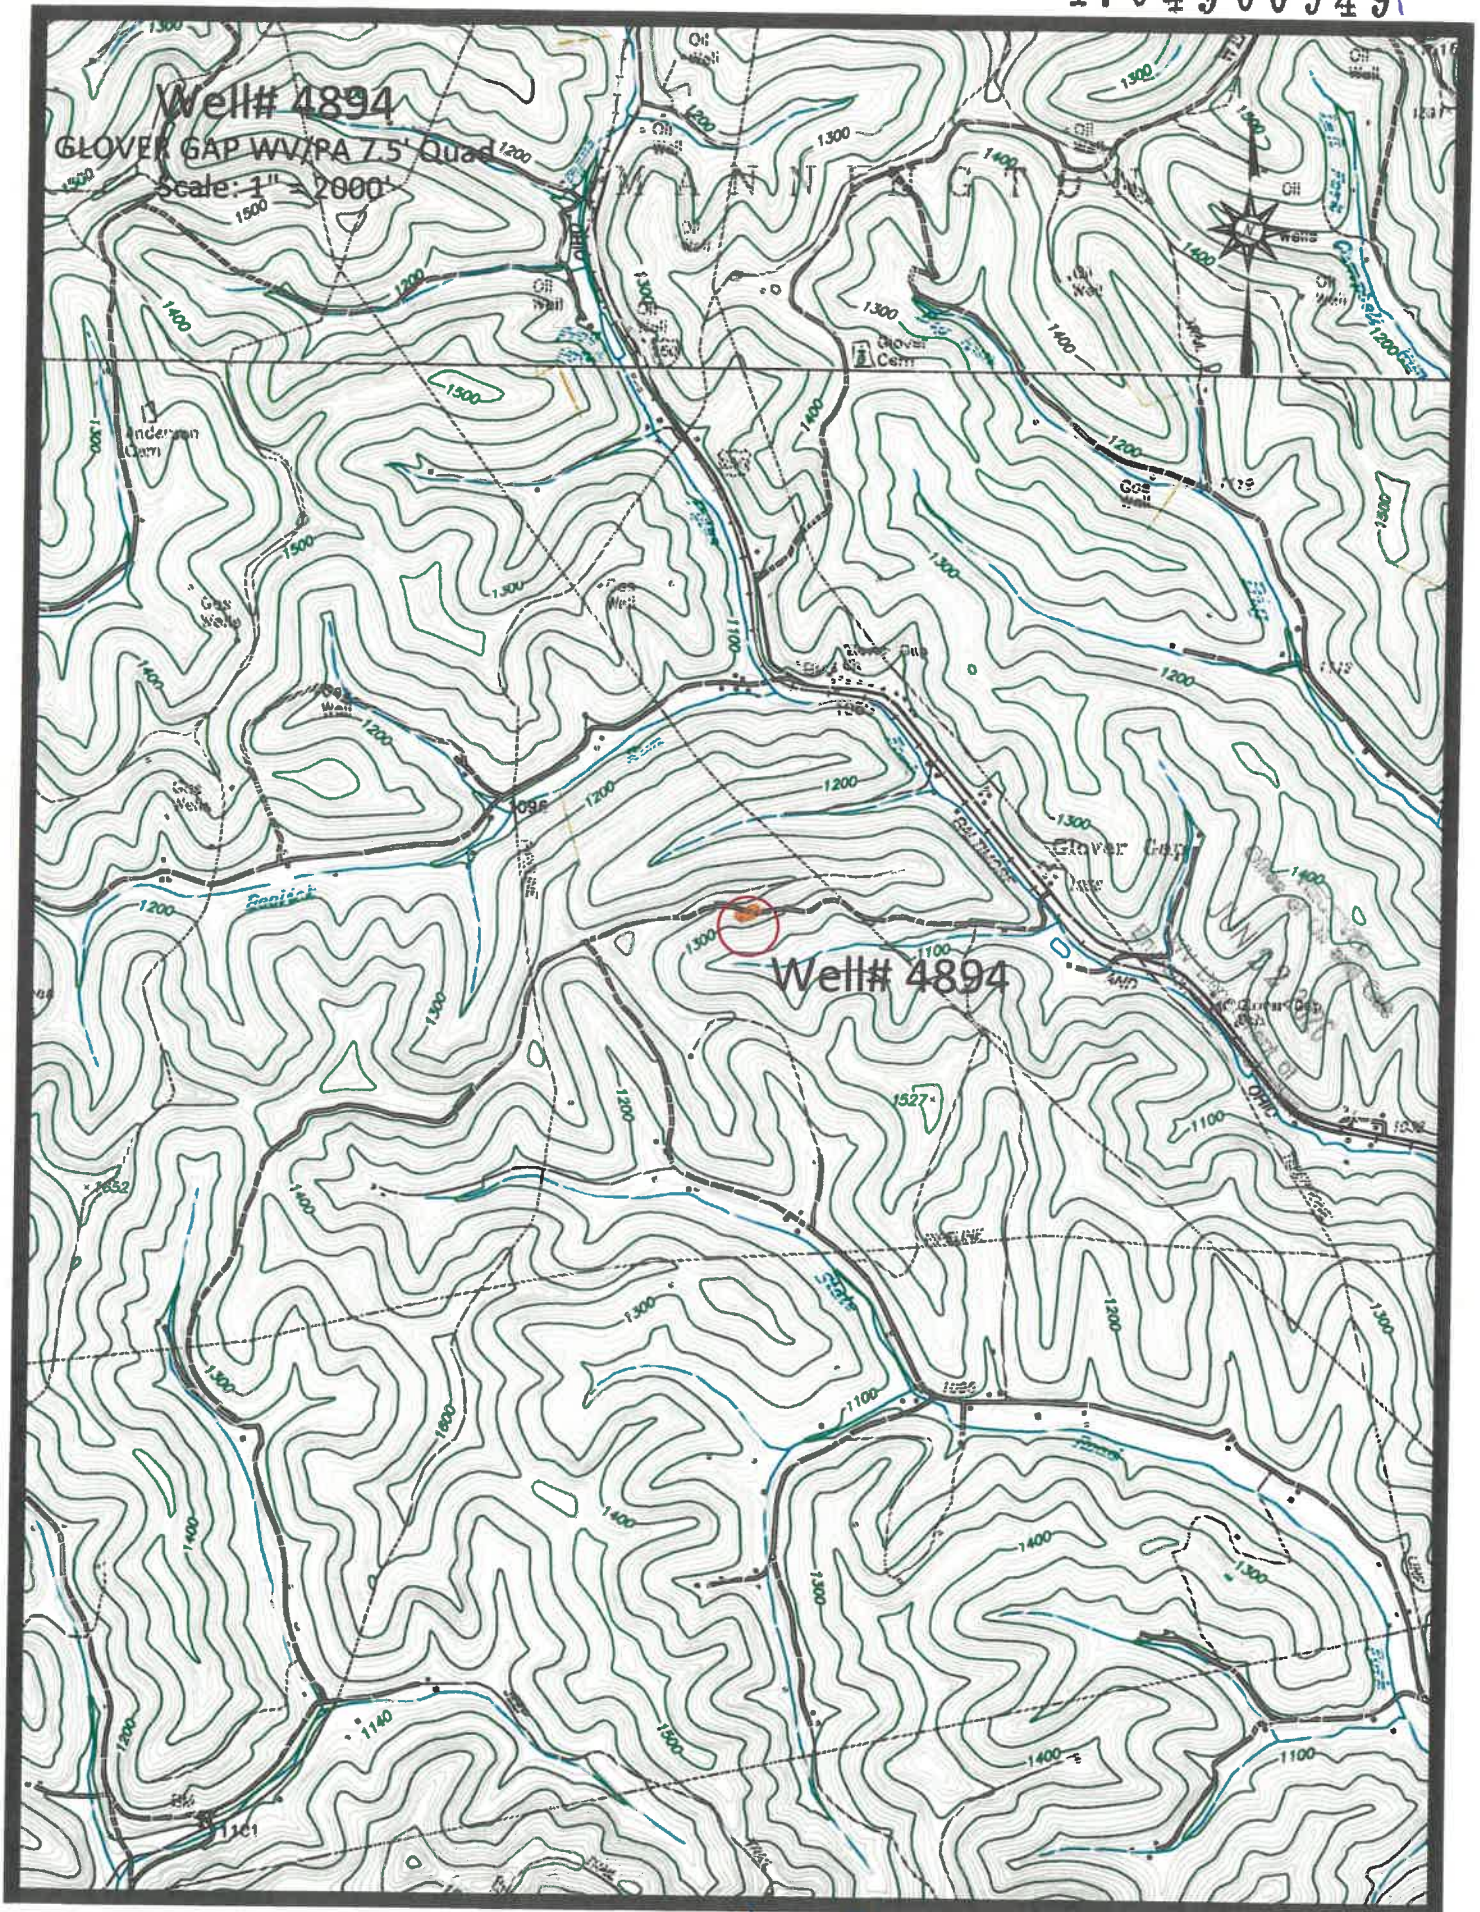

Arisee Rural

07/31/2026

4704900949P

7.5 MINUTE SERIES (TOPOGRAPHIC)
SW/4 MANNINGTON 15' QUADRANGLE

CWA

25'

51

1 750 000 FEET

53

80°22'30"

39°37'30"

410 000
FEET



WW-7
8-30-06



4704900949P
Office of Oil and Gas
JUN 22 2026
WV Department of
Environmental Protection

West Virginia Department of Environmental Protection
Office of Oil and Gas

WELL LOCATION FORM: GPS

API: 47-049-00949 WELL NO.: 4894

FARM NAME: O'HARA #1

RESPONSIBLE PARTY NAME: WEST VIRGINIA LAND RESOURCES INC.

COUNTY: MARION DISTRICT: MANNINGTON

QUADRANGLE: GLOVER GAP, WV

SURFACE OWNER: SHAUN KUHN ETAL

ROYALTY OWNER: _____

UTM GPS NORTHING: 4,384,465 m (1309')

UTM GPS EASTING: 550,099 m GPS ELEVATION: 398 m

The Responsible Party named above has chosen to submit GPS coordinates in lieu of preparing a new well location plat for a plugging permit or assigned API number on the above well. The Office of Oil and Gas will not accept GPS coordinates that do not meet the following requirements:

1. Datum: NAD 1983, Zone: 17 North, Coordinate Units: meters, Altitude: height above mean sea level (MSL) – meters.
2. Accuracy to Datum – 3.05 meters
3. Data Collection Method:

Survey grade GPS X: Post Processed Differential X

Real-Time Differential _____

Mapping Grade GPS _____: Post Processed Differential _____

Real-Time Differential _____

4. Letter size copy of the topography map showing the well location.

I the undersigned, hereby certify this data is correct to the best of my knowledge and belief and shows all the information required by law and the regulations issued and prescribed by the Office of Oil and Gas.

Signature

PS 2002

Title

JUNE 4, 2026

Date

07/31/2026