

WW-7
8-30-06



West Virginia Department of Environmental Protection
Office of Oil and Gas
WELL LOCATION FORM: GPS

API: 47-049-01015 WELL NO.: 1

FARM NAME: E.J. Freeland

RESPONSIBLE PARTY NAME: Danny Caldwell

COUNTY: Marion DISTRICT: Mannington

QUADRANGLE: Glover Gap

SURFACE OWNER: Katherine V. Glover

ROYALTY OWNER: _____

UTM GPS NORTHING: 4685508.77

UTM GPS EASTING: 551559.92 GPS ELEVATION: 1216'

The Responsible Party named above has chosen to submit GPS coordinates in lieu of preparing a new well location plat for a plugging permit or assigned API number on the above well. The Office of Oil and Gas will not accept GPS coordinates that do not meet the following requirements:

1. Datum: NAD 1983, Zone: 17 North, Coordinate Units: meters, Altitude: height above mean sea level (MSL) – meters.
2. Accuracy to Datum – 3.05 meters
3. Data Collection Method:

Survey grade GPS _____: Post Processed Differential _____

Real-Time Differential _____

Mapping Grade GPS X: Post Processed Differential X

Real-Time Differential _____

4. **Letter size copy of the topography map showing the well location.**


I the undersigned, hereby certify this data is correct to the best of my knowledge and belief and shows all the information required by law and the regulations issued and prescribed by the Office of Oil and Gas.

Danny R Caldwell
Signature

Maintenance Coordinator
Title

1/14/2020
Date


RECEIVED
Office of Oil and Gas
JAN 22 2020
WV Department of
Environmental Protection

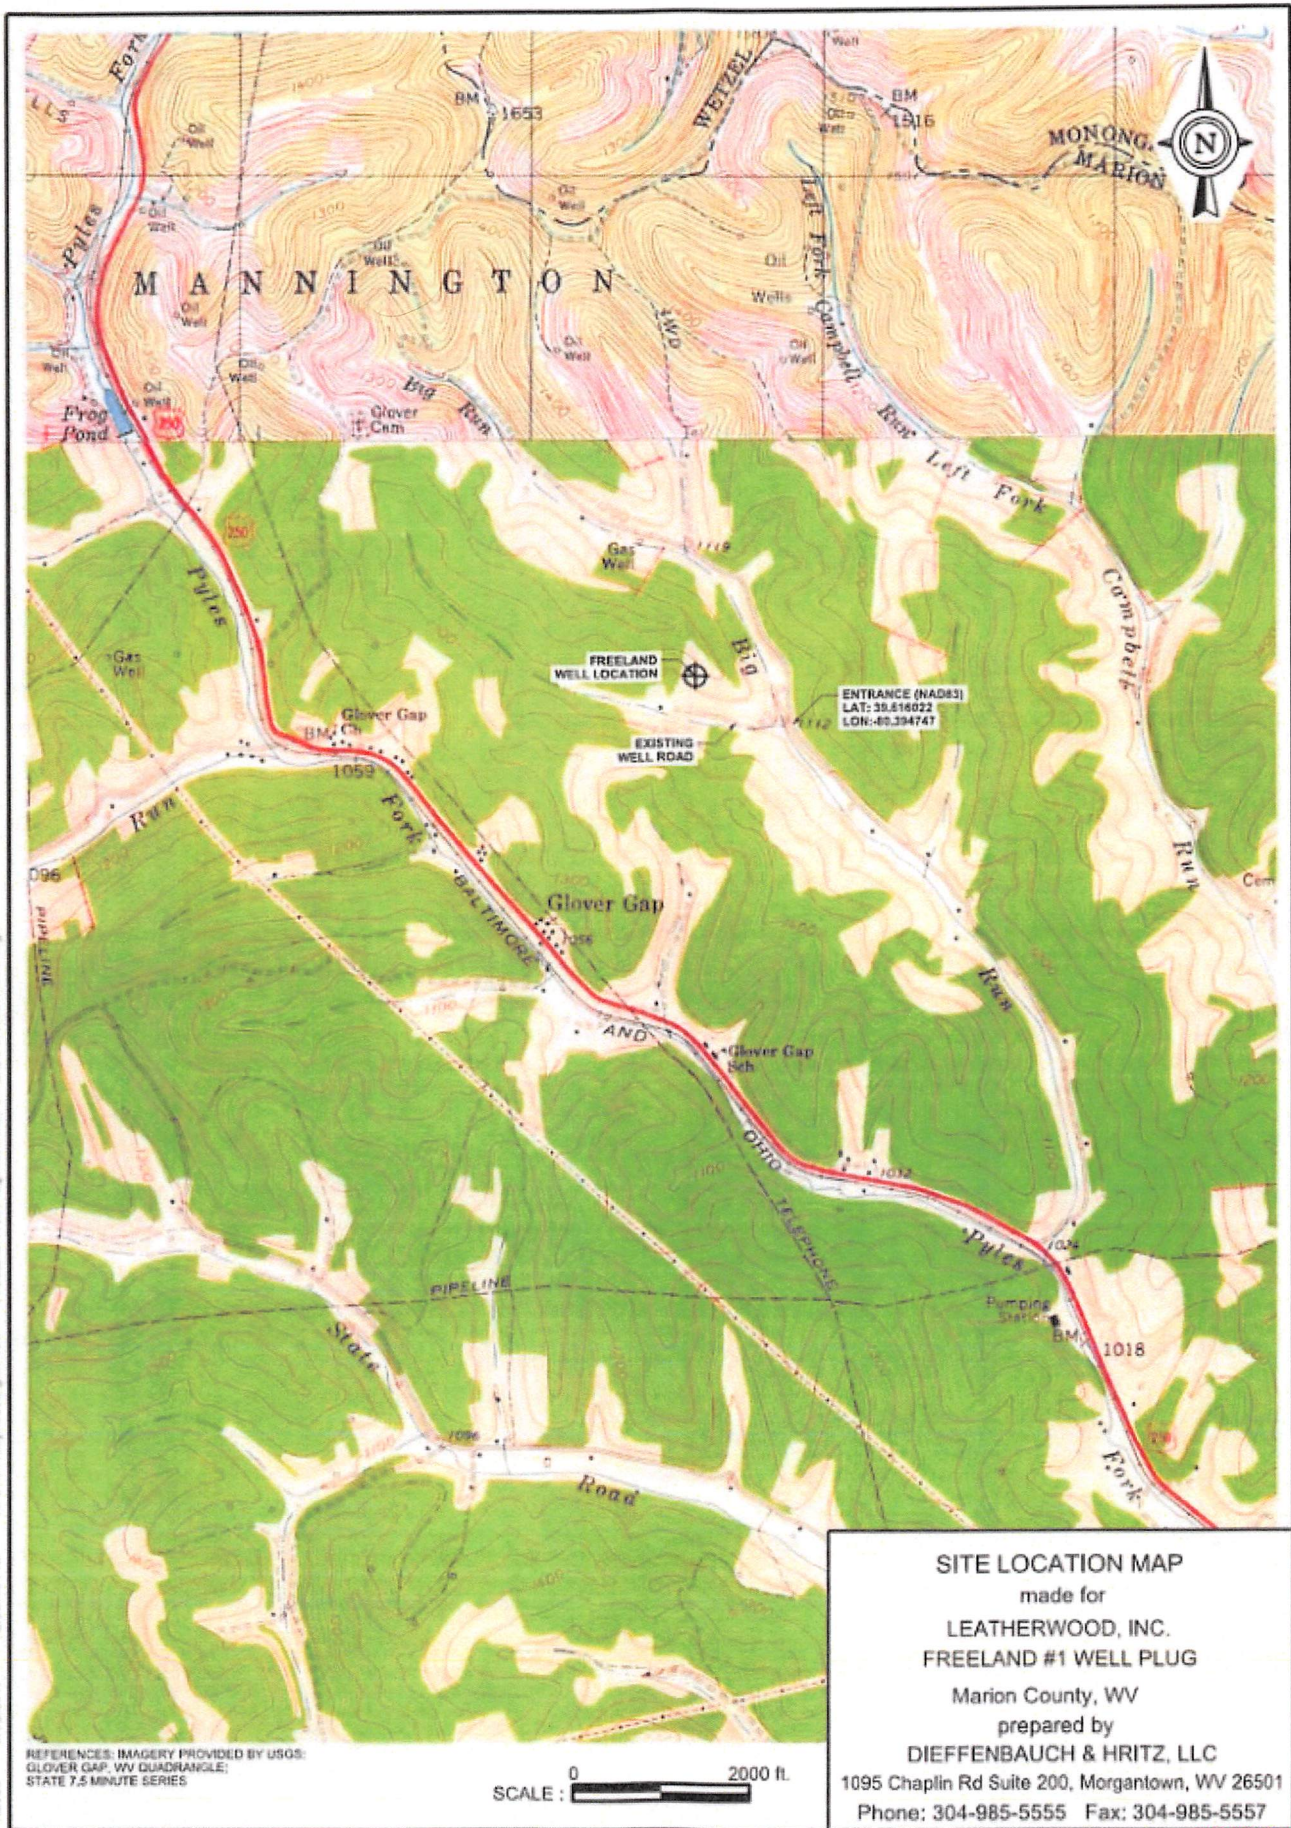

1:2000 5/16/2017 2:03:18 PM K:\CNX\Waynesburg\1710014 - Freiland Well Plug\Comment\SITE LOCATION MAP.dgn

REFERENCES: IMAGERY PROVIDED BY USGS;
 GLOVER GAP, WV QUADRANGLE;
 STATE 7.5 MINUTE SERIES

THIS PLAN IS FOR THE PLUGGING OF AN EXISTING WELL.
THE ENTIRE LENGTH OF ACCESS IS EXISTING WELL ROAD.
ROCK WILL BE USED WHERE NECESSARY.

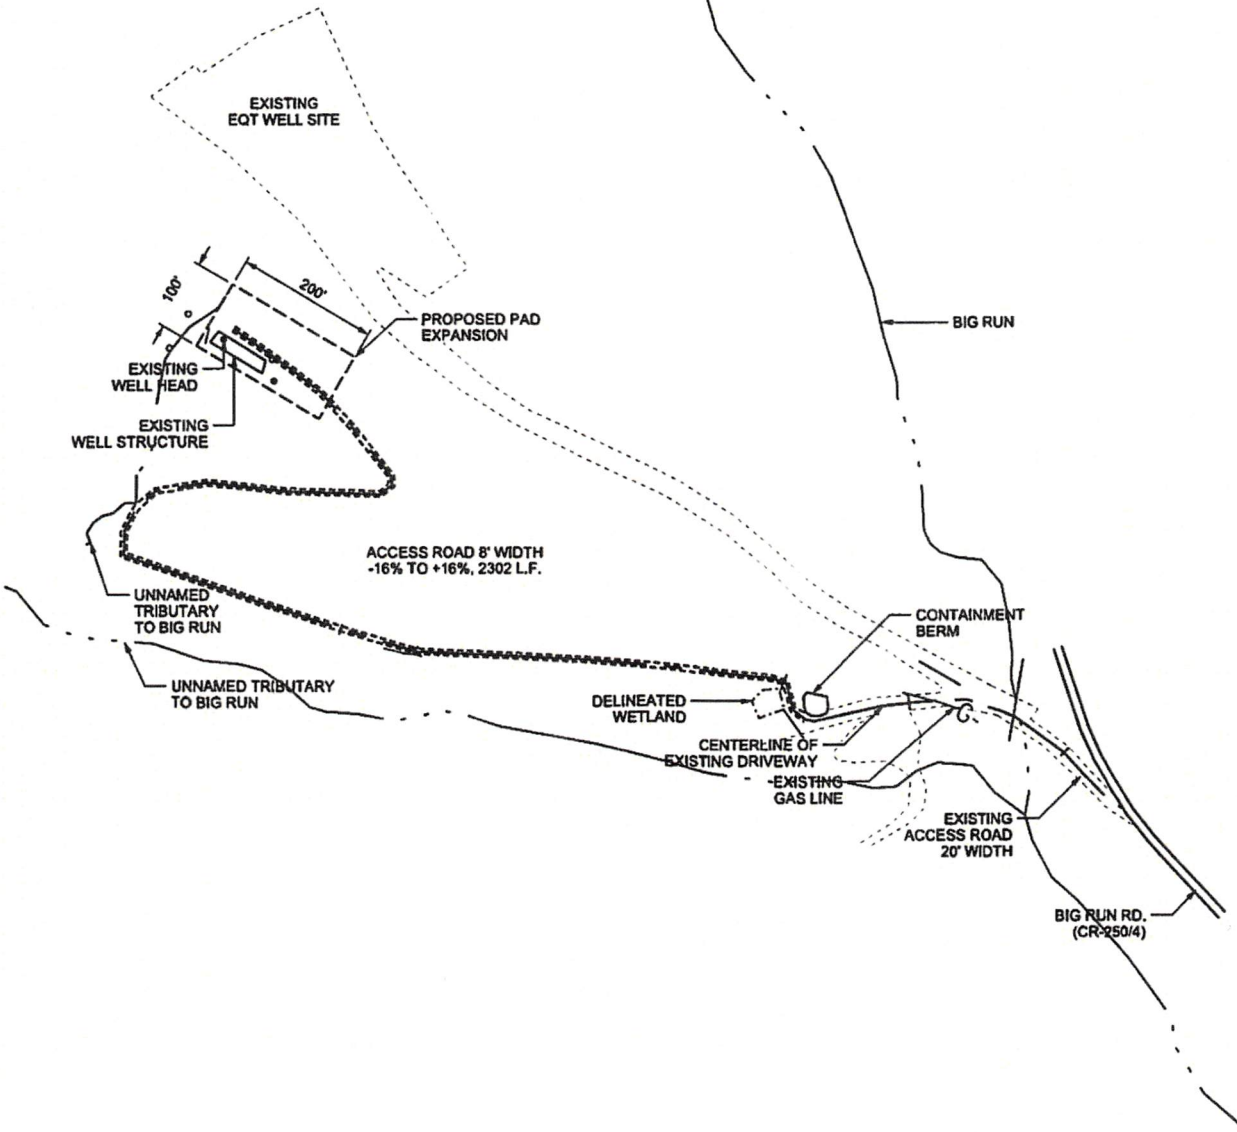

K:\CNX\Waynesburg\1716014 - Freeland Well Plug\Plans\SITE PLAN\SITE PLAN - WW9.dgn
7:13:03 PM
5/30/2017
1:250

WV Department of Environmental Protection

RECEIVED
Office of Oil and Gas
JAN 22 2020

RECEIVED
Office of Oil and Gas

AUG 29 2017

WV Department of Environmental Protection



DRAWINGS TO ACCOMPANY FORM WW-9	
LEATHERWOOD INC.	
1000 CONSOL ENERGY DRIVE	
CANONSBURG, PA 15317	
WATERSHED: BUFFALO CREEK	
DISTRICT: MANNINGTON	COUNTY: MARION
QUADRANGLE: GLOVER GAP	WELL NO.: FREELAND #1
DATE: 5/30/2017	

11/10/2017