

WW-7
8-30-06



West Virginia Department of Environmental Protection
Office of Oil and Gas

WELL LOCATION FORM: GPS

API: 47-049-01022 WELL NO.: 1

FARM NAME: KOEN

RESPONSIBLE PARTY NAME: Gerald Ramsburg

COUNTY: MARION DISTRICT: MANNINGTON

QUADRANGLE: MANNINGTON

SURFACE OWNER: Shenal, Elizabeth T & Robert F Jr

ROYALTY OWNER: _____

UTM GPS NORTHING: 4380923.09m (998')

UTM GPS EASTING: 554503.48m GPS ELEVATION: 304.276m

The Responsible Party named above has chosen to submit GPS coordinates in lieu of preparing a new well location plat for a plugging permit or assigned API number on the above well. The Office of Oil and Gas will not accept GPS coordinates that do not meet the following requirements:

1. Datum: NAD 1983, Zone: 17 North, Coordinate Units: meters, Altitude: height above mean sea level (MSL) – meters.
2. Accuracy to Datum – 3.05 meters
3. Data Collection Method:

Survey grade GPS ____: Post Processed Differential ____

Real-Time Differential ____

Mapping Grade GPS : Post Processed Differential

Real-Time Differential ____

4. Letter size copy of the topography map showing the well location.

I the undersigned, hereby certify this data is correct to the best of my knowledge and belief and shows all the information required by law and the regulations issued and prescribed by the Office of Oil and Gas.

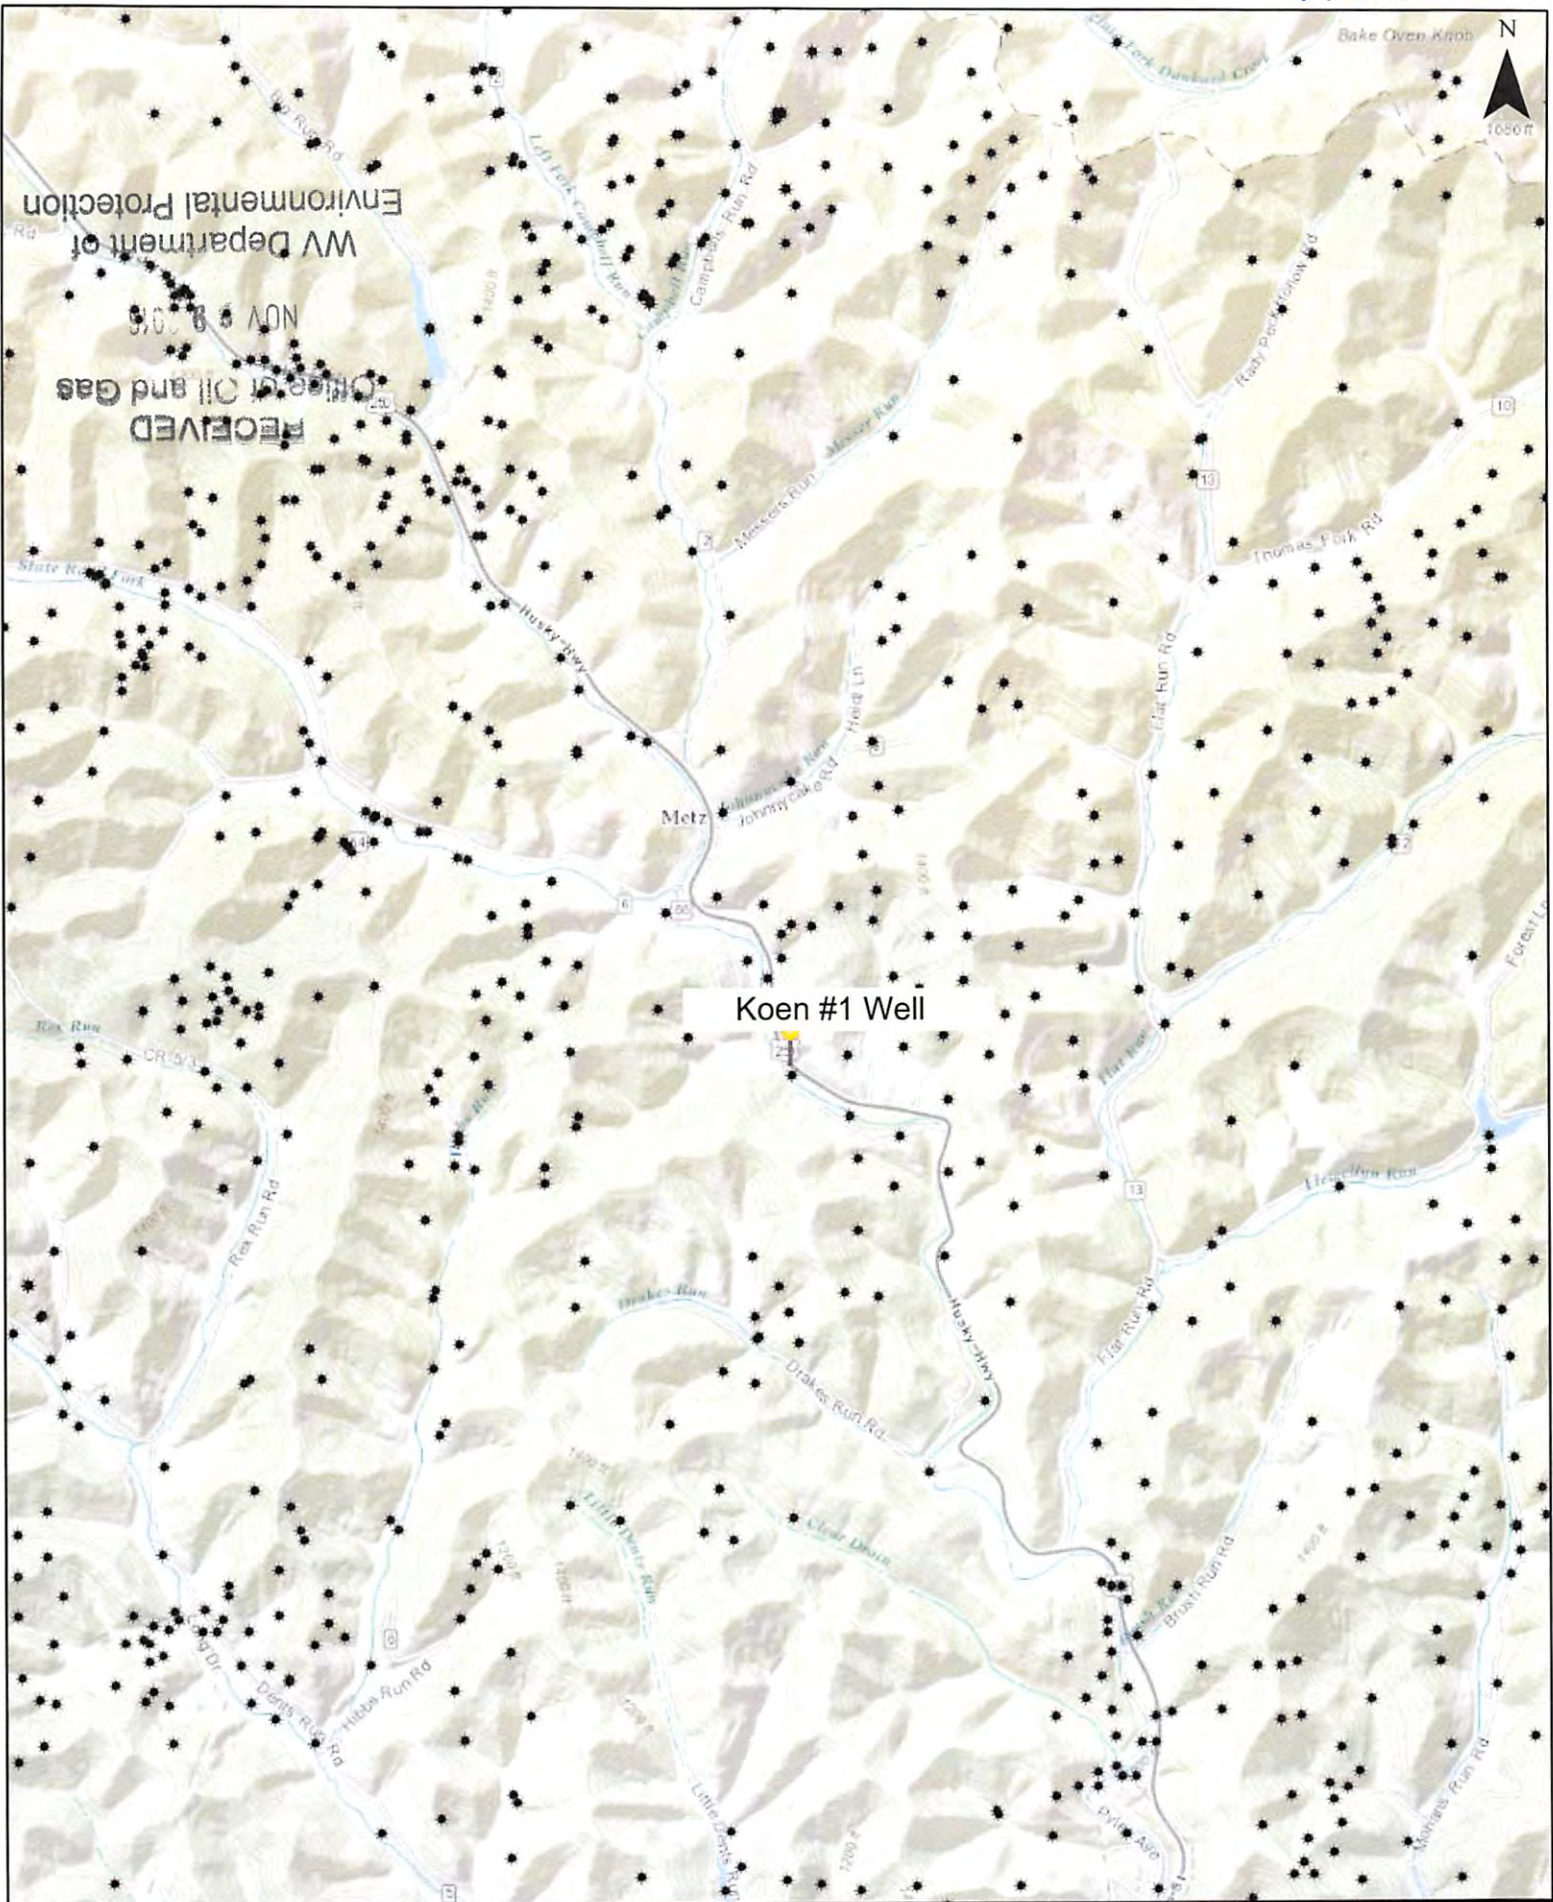

Signature

General Manager

Title

11/23/14
Date

01/20/2017



Koen #1 Well

RECEIVED
 Office of Oil and Gas
 NOV 9 8 2016
 WV Department of
 Environmental Protection

- Legend
- WhiteStar Wells
 - ★ CNX Utica Well Pad Centers - Drilled
 - ★ CNX Marcellus Well Pad Centers - Drilled

0 1,000 2,000 4,000 6,000 Feet
 Date: 11/18/2016 Prepared By: BLZ

EMPPOWER ENERGY
CONSOL ENERGY
 Location Map Koen #1 Well

This product was generated by
 CONSOL Energy's WEB Map.
 Intended for Internal Use Only.