

WW-7
8-30-06



West Virginia Department of Environmental Protection
Office of Oil and Gas

WELL LOCATION FORM: GPS

API: 47-049-01339 WELL NO.: E-0530

FARM NAME: Ice, Richard A.

RESPONSIBLE PARTY NAME: XTO Energy, Inc.

COUNTY: Marion DISTRICT: Lincoln

QUADRANGLE: Shinnston

SURFACE OWNER: Lester L. Crim & Sharon H. Moore

ROYALTY OWNER: See attached list

UTM GPS NORTHING: 4371038.1

UTM GPS EASTING: 559080.4 GPS ELEVATION: 343 meters (1125')

The Responsible Party named above has chosen to submit GPS coordinates in lieu of preparing a new well location plat for a plugging permit or assigned API number on the above well. The Office of Oil and Gas will not accept GPS coordinates that do not meet the following requirements:

1. Datum: NAD 1983, Zone: 17 North, Coordinate Units: meters, Altitude: height above mean sea level (MSL) – meters.

2. Accuracy to Datum – 3.05 meters

3. Data Collection Method:

Survey grade GPS ; Post Processed Differential

Real-Time Differential

Mapping Grade GPS ; Post Processed Differential

Real-Time Differential

4. Letter size copy of the topography map showing the well location.

I the undersigned, hereby certify this data is correct to the best of my knowledge and belief and shows all the information required by law and the regulations issued and prescribed by the Office of Oil and Gas.

Signature

Project Manager

Title


June 30, 2015

Date

08/07/2015

Received
Office of Oil & Gas

JUL 20 2015

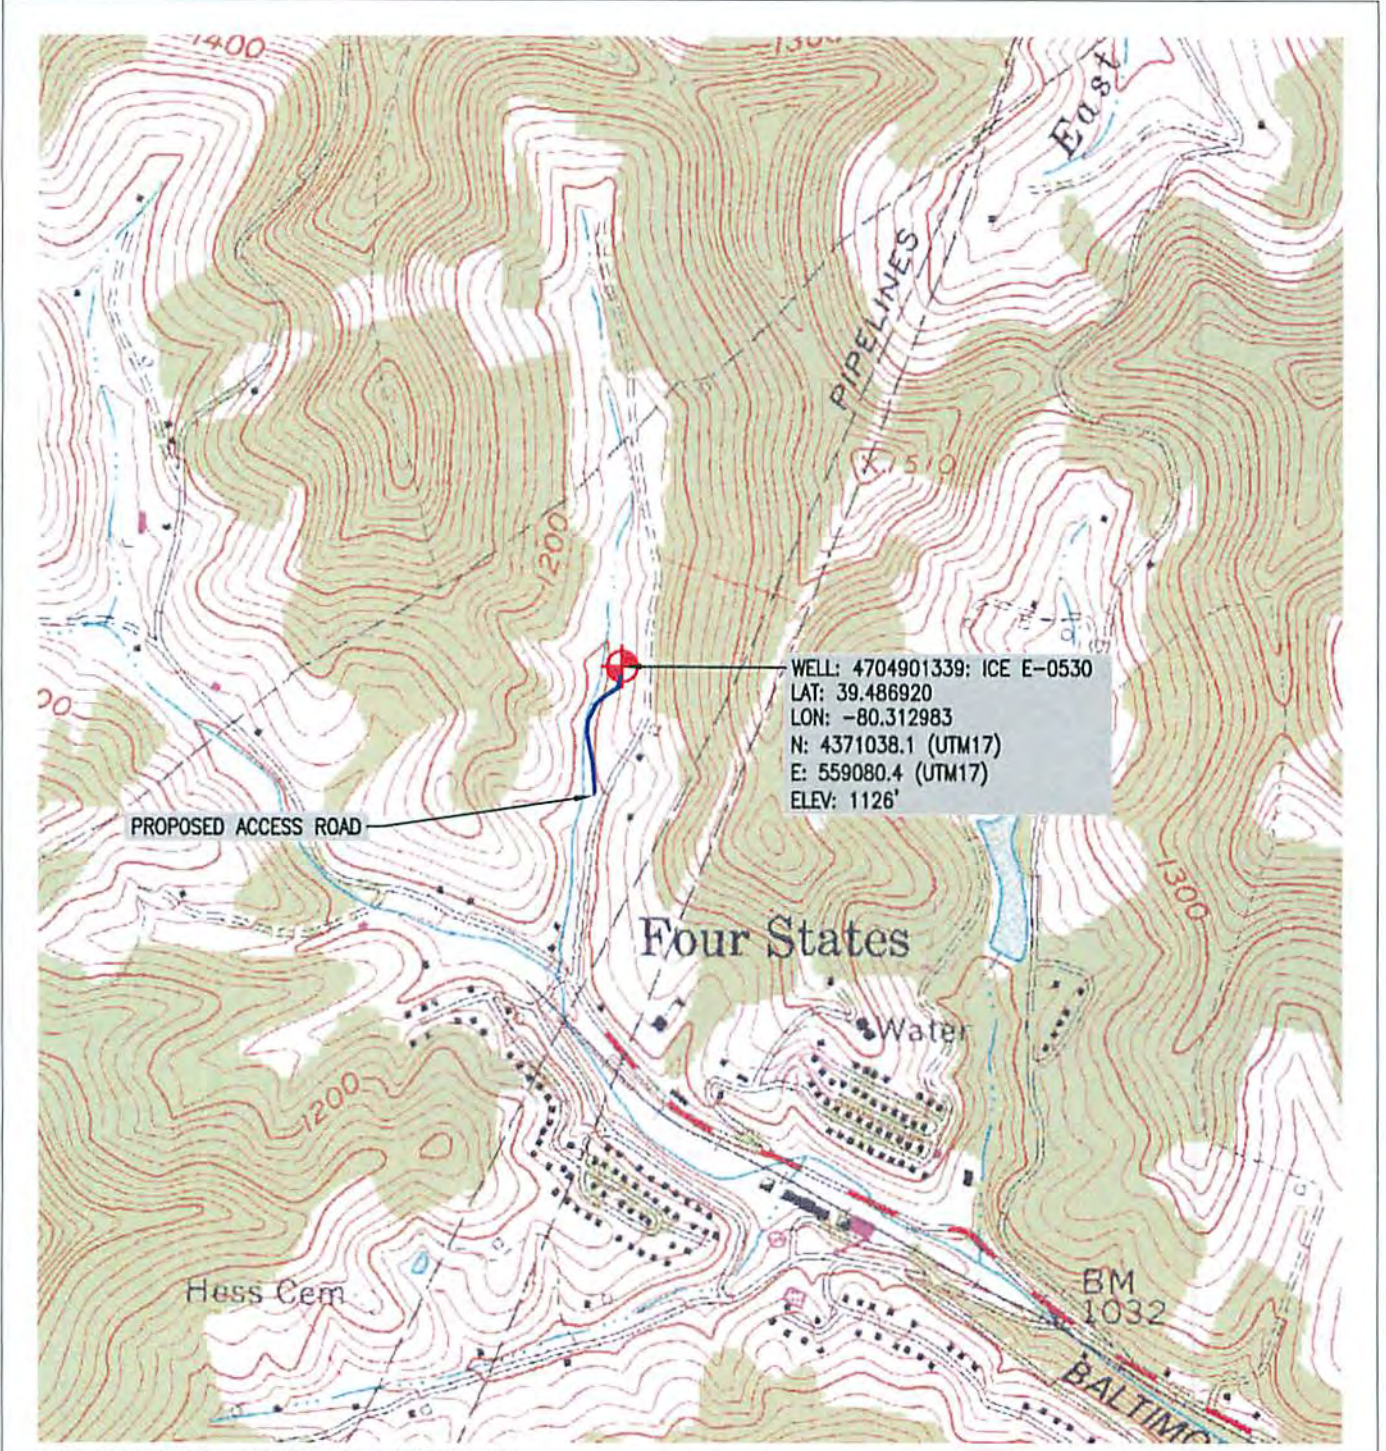

MAP REFERENCE: U.S.G.S. SHINNSTON, WV

<p>WV NORTH ZONE SPCS GRID NORTH</p>	<p>XTO ENERGY 810 HOUSTON STREET FORT WORTH, TX 76102</p>	<p>TRI-COUNTY ENGINEERING, LLC An ENERCON Company 319 Paintersville Road Hunker, PA 15639 www.tricountyeng.com</p>	
		<p>Voice: (724) 635-0210 Fax: (724) 635-0676</p>	
<p>0' 1000' SCALE 1" = 1000'</p>	<p>Excellence-Every project. Every day.</p>	<p>LOCATION MAP</p> <p>ICE E-0530 WELL PLUG</p>	
		<table border="1"> <tr> <td> DRAWN BY: ZJC DATE: 6/18/2015 SCALE: AS NOTED </td> <td> LINCOLN DISTRICT, MARION COUNTY, WEST VIRGINIA SHEET: 1 OF 1 FILE NO. 0661-05 </td> </tr> </table>	
DRAWN BY: ZJC DATE: 6/18/2015 SCALE: AS NOTED	LINCOLN DISTRICT, MARION COUNTY, WEST VIRGINIA SHEET: 1 OF 1 FILE NO. 0661-05		

WRN 08/07/2015
7-14-15