

WW-7
8-30-06



West Virginia Department of Environmental Protection
Office of Oil and Gas
WELL LOCATION FORM: GPS

API: 4704901398 WELL NO.: L65

FARM NAME: Raber

RESPONSIBLE PARTY NAME: CNX Gas Company

COUNTY: Marion DISTRICT: Mannington

QUADRANGLE: Mannington

SURFACE OWNER: Brenda J Raber

ROYALTY OWNER: _____

UTM GPS NORTHING: 4383511.30

UTM GPS EASTING: 555718.94 GPS ELEVATION: 452.68 m / 1485.16 ft

The Responsible Party named above has chosen to submit GPS coordinates in lieu of preparing a new well location plat for a plugging permit or assigned API number on the above well. The Office of Oil and Gas will not accept GPS coordinates that do not meet the following requirements:

1. Datum: NAD 1983, Zone: 17 North, Coordinate Units: meters, Altitude: height above mean sea level (MSL) – meters.
2. Accuracy to Datum – 3.05 meters
3. Data Collection Method:

Survey grade GPS _____ : Post Processed Differential _____

Real-Time Differential _____

Mapping Grade GPS : Post Processed Differential

Real-Time Differential _____

4. **Letter size copy of the topography map showing the well location.**

I the undersigned, hereby certify this data is correct to the best of my knowledge and belief and shows all the information required by law and the regulations issued and prescribed by the Office of Oil and Gas.

Raymond
Signature


Project Manager
Title

12-12-19
Date

RECEIVED
Office of Oil and Gas

DEC 17 2019

WV Department of
Environmental Protection

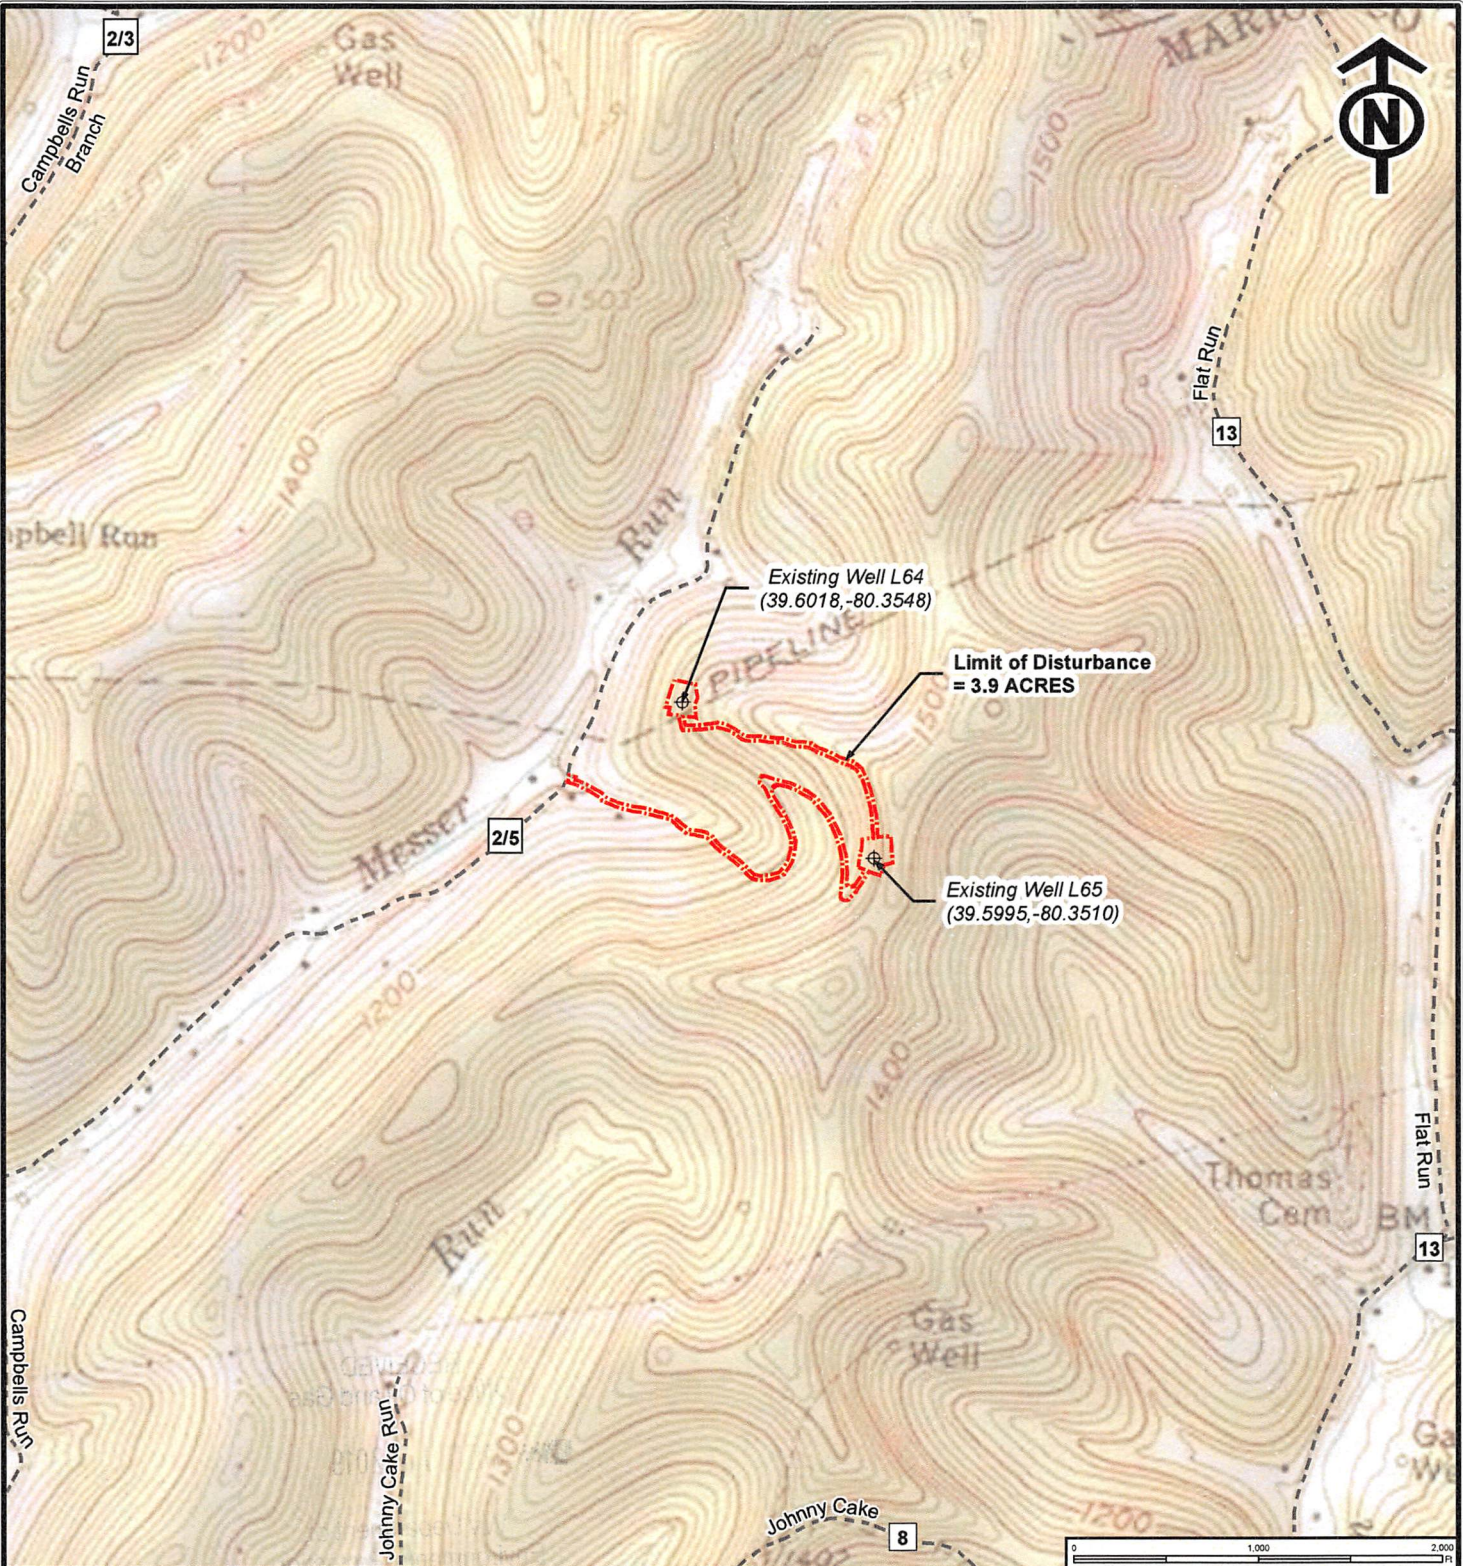

LEGEND

- ⊕ Existing Well
- - - - Limit of Disturbance
- - - - Roads

Prepared By:



www.keystoneconsultants.net 412-278-2100

| REV | DESCRIPTION | DATE |
|-----|-------------|------|
| | | |
| | | |
| | | |
| | | |



**L64, L65 Well Plugging
Site Location Topographic Map**

Marion County, WV

DRAWING NUMBER: 001

DWN BY: GDM APR BY: RDM DATE: 10/2/2019

SCALE: 1" = 1,000 feet SHEET: 1 OF 2