

WW-7
8-30-06



West Virginia Department of Environmental Protection
Office of Oil and Gas

WELL LOCATION FORM: GPS

API: 4704901410 WELL NO.: L-96

FARM NAME: _____

RESPONSIBLE PARTY NAME: CNX Gas Company

COUNTY: Marion DISTRICT: Paw Paw

QUADRANGLE: Mannington

SURFACE OWNER: Consolidation Coal Company

ROYALTY OWNER: _____

UTM GPS NORTHING: 4383644.97

UTM GPS EASTING: 559824.28 GPS ELEVATION: 460.21 m / 1509.89 ft

The Responsible Party named above has chosen to submit GPS coordinates in lieu of preparing a new well location plat for a plugging permit or assigned API number on the above well. The Office of Oil and Gas will not accept GPS coordinates that do not meet the following requirements:

- Datum: NAD 1983, Zone: 17 North, Coordinate Units: meters, Altitude: height above mean sea level (MSL) – meters.
- Accuracy to Datum – 3.05 meters
- Data Collection Method:

Survey grade GPS _____ : Post Processed Differential _____
Real-Time Differential _____

Mapping Grade GPS X : Post Processed Differential X
Real-Time Differential _____

- Letter size copy of the topography map showing the well location.**



I the undersigned, hereby certify this data is correct to the best of my knowledge and belief and shows all the information required by law and the regulations issued and prescribed by the Office of Oil and Gas.

Raymond
Signature

PM
Title

1-6-2020
Date

RECEIVED
Office of Oil and Gas
1-6-2020
WV Department of Environmental Protection

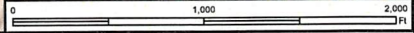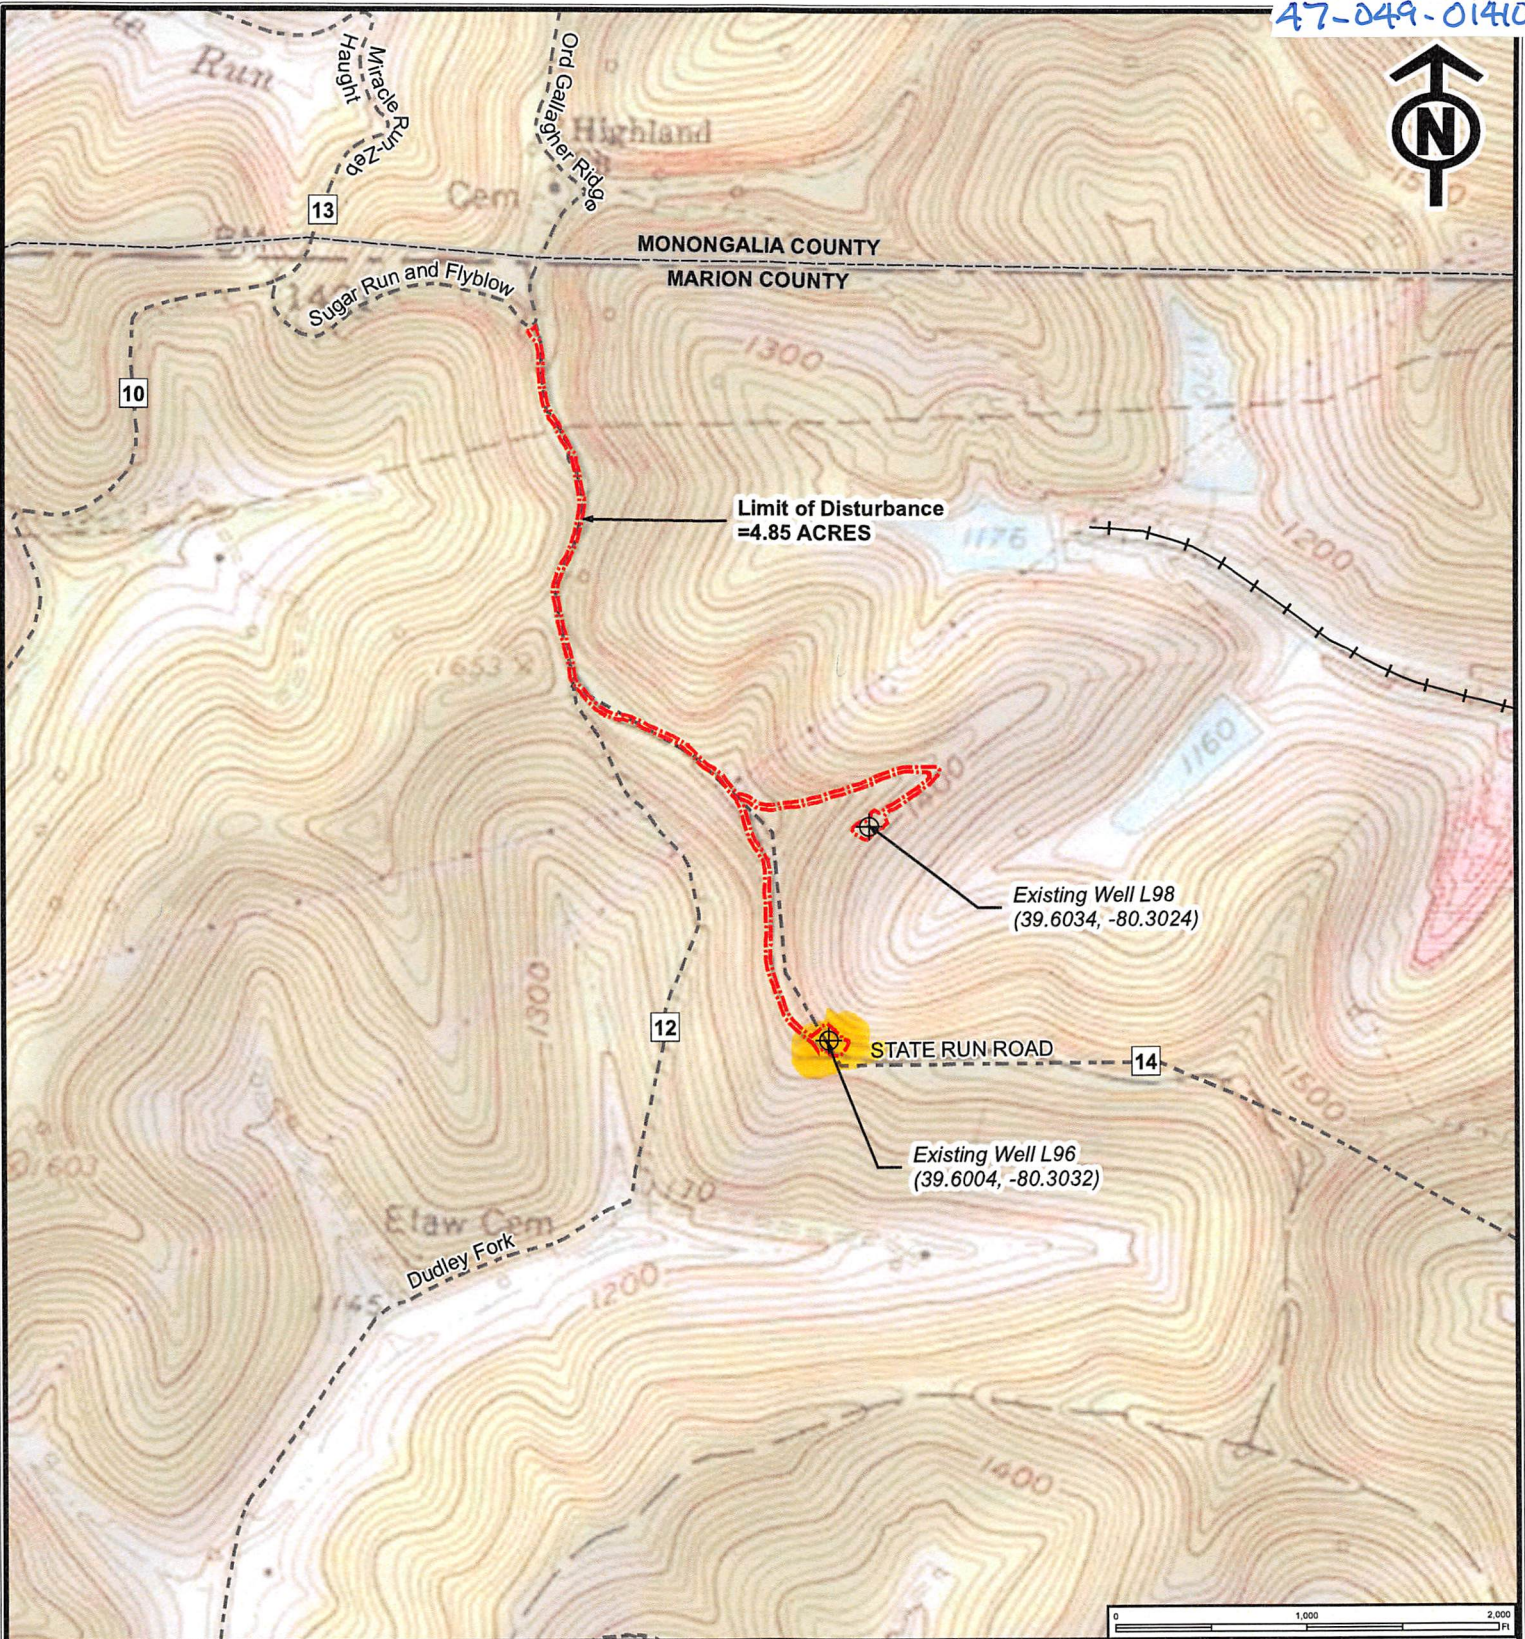

LEGEND

- Existing Well
- Limit of Disturbance
- Road
- Railroad
- County Boundary

Prepared By: **KEYSTONE CONSULTANTS INC.**
www.keystoneconsultants.net 412-278-2100

REV	DESCRIPTION	DATE



**L96/L98 Well Plugging
Site Location Topographic Map**

Marion County, WV

DRAWING NUMBER: 001

DWN BY: GDM	APR BY: EAZ	DATE: 12/30/19
-------------	-------------	----------------

SCALE: 1" = 1,000 feet	SHEET: 1 OF 1
------------------------	---------------