

WW-7  
8-30-06



West Virginia Department of Environmental Protection  
Office of Oil and Gas  
**WELL LOCATION FORM: GPS**

API: 4704901634 WELL NO.: L-98

FARM NAME: \_\_\_\_\_

RESPONSIBLE PARTY NAME: CNX Gas Company

COUNTY: Marion DISTRICT: Paw Paw

QUADRANGLE: Mannington

SURFACE OWNER: Consolidation Coal Company

ROYALTY OWNER: \_\_\_\_\_

UTM GPS NORTHING: 4383980.72

UTM GPS EASTING: 559882.60 GPS ELEVATION: 425.82 m / 1397.04 ft

The Responsible Party named above has chosen to submit GPS coordinates in lieu of preparing a new well location plat for a plugging permit or assigned API number on the above well. The Office of Oil and Gas will not accept GPS coordinates that do not meet the following requirements:

- Datum: NAD 1983, Zone: 17 North, Coordinate Units: meters, Altitude: height above mean sea level (MSL) – meters.
- Accuracy to Datum – 3.05 meters
- Data Collection Method:

Survey grade GPS \_\_\_\_\_: Post Processed Differential \_\_\_\_\_

Real-Time Differential \_\_\_\_\_

Mapping Grade GPS X: Post Processed Differential X

Real-Time Differential \_\_\_\_\_

RECEIVED  
Office of Oil and Gas

JAN 08 2020

WV Department of  
Environmental Protection

- Letter size copy of the topography map showing the well location.**


I the undersigned, hereby certify this data is correct to the best of my knowledge and belief and shows all the information required by law and the regulations issued and prescribed by the Office of Oil and Gas.

Raymond Dean  
Signature

PM  
Title

1-6-2020  
Date

47-049-01634P

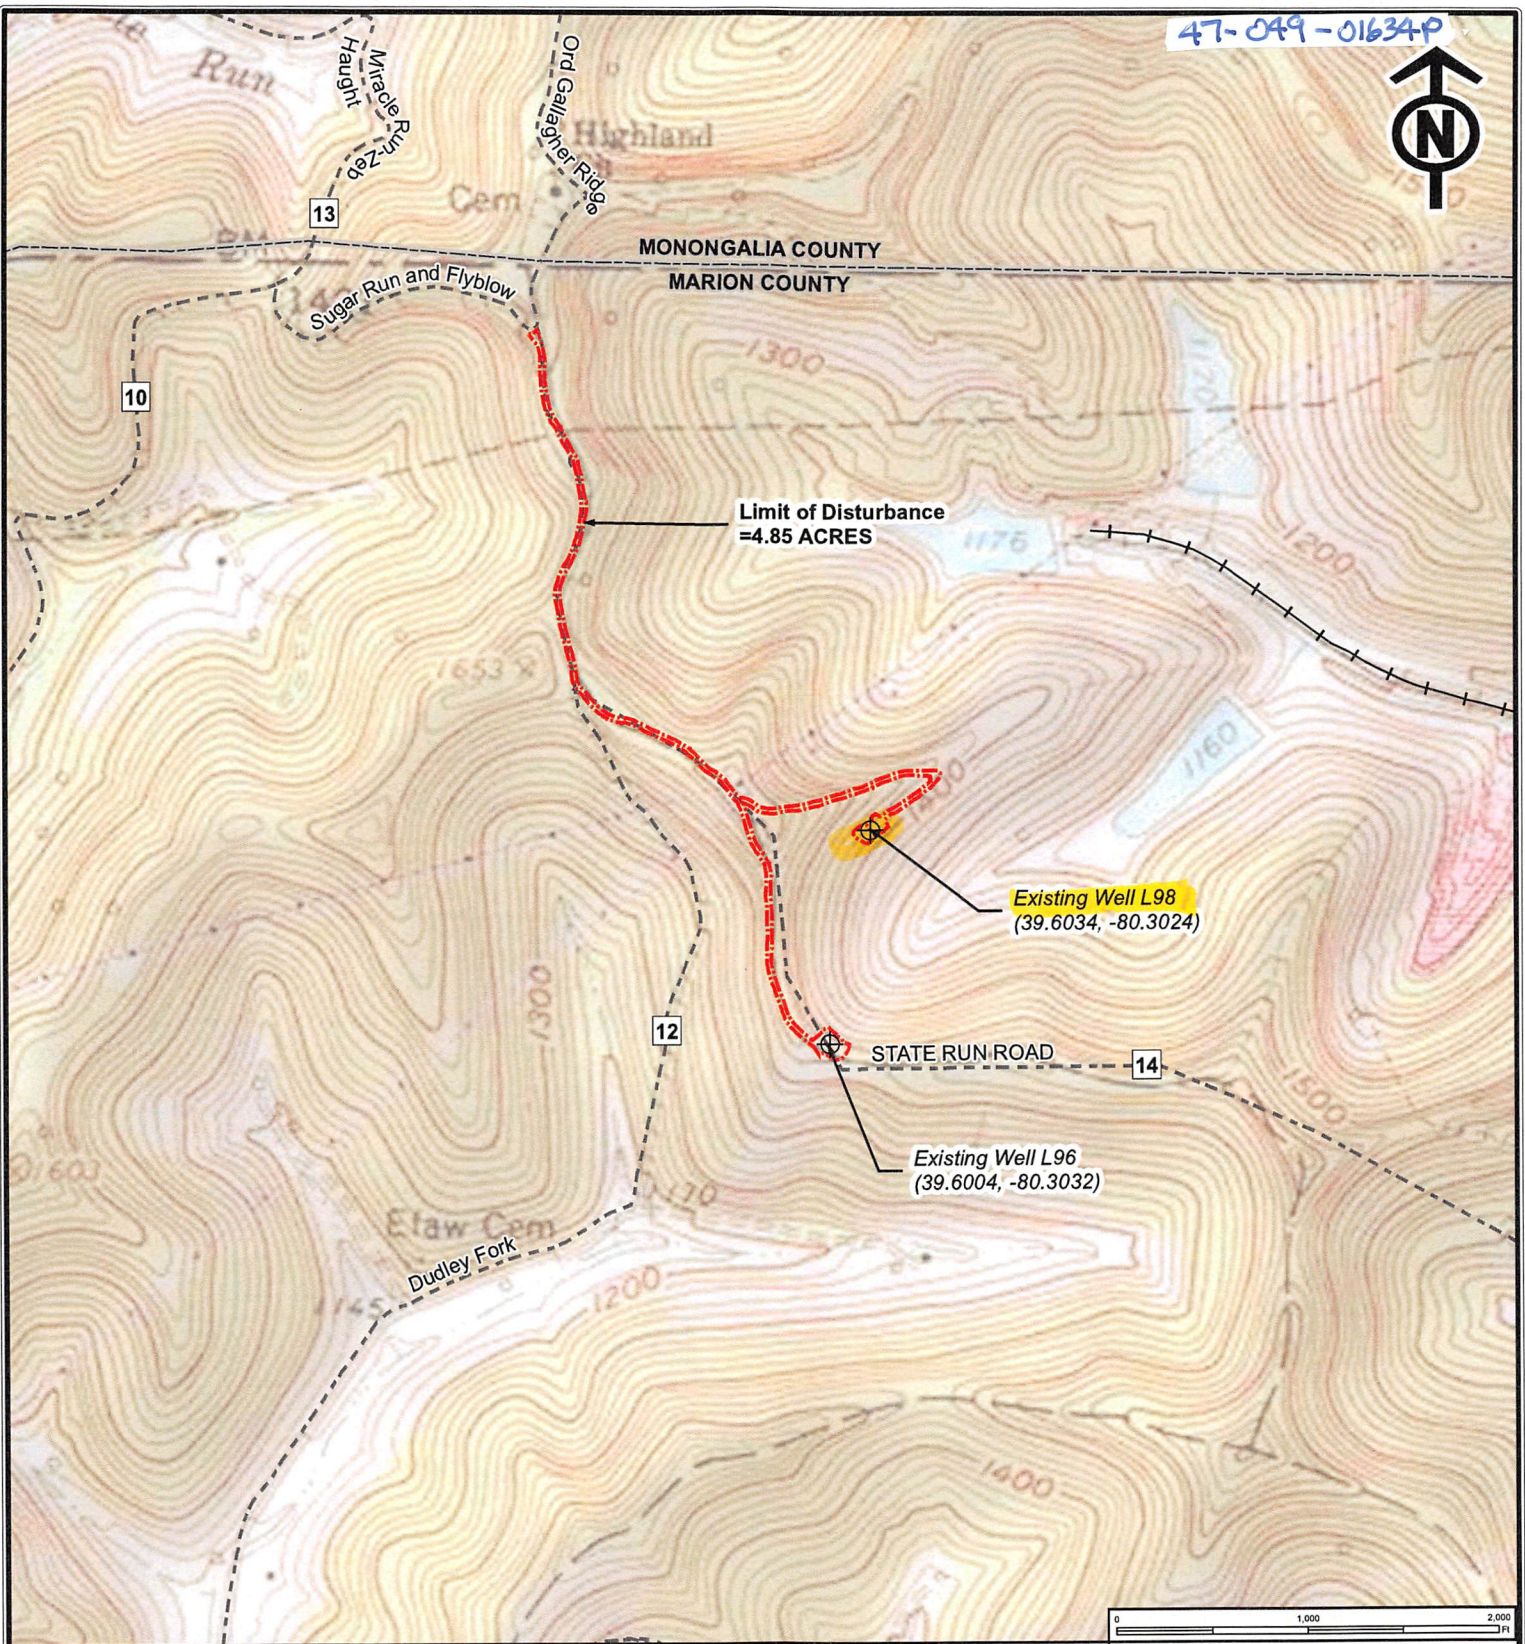

**LEGEND**

- Existing Well
- Limit of Disturbance
- Road
- Railroad
- County Boundary

Prepared By:

**KEYSTONE**  
CONSULTANTS, INC.  
www.keystoneconsultants.net 412-278-2100

REV	DESCRIPTION	DATE



**L96/L98 Well Plugging  
Site Location Topographic Map**

Marion County, WV

DRAWING NUMBER: 001

DWN BY: GDM    APR BY: EAZ    DATE: 12/30/19

SCALE: 1" = 1,000 feet

SHEET: 1 OF 1