

WW-7
8-30-06



West Virginia Department of Environmental Protection
Office of Oil and Gas
WELL LOCATION FORM: GPS

API: 4704901707 WELL NO.: 8D1 CCR
 FARM NAME: Consolidation Coal Company
 RESPONSIBLE PARTY NAME: CNX
 COUNTY: Marion DISTRICT: Mannington
 QUADRANGLE: Mannington
 SURFACE OWNER: Consolidation Coal Company
 ROYALTY OWNER: Consolidation Coal Company
 UTM GPS NORTHING: 4384222.03
 UTM GPS EASTING: 554654.65 GPS ELEVATION: 1232.95

The Responsible Party named above has chosen to submit GPS coordinates in lieu of preparing a new well location plat for a plugging permit or assigned API number on the above well. The Office of Oil and Gas will not accept GPS coordinates that do not meet the following requirements:

- Datum: NAD 1983, Zone: 17 North, Coordinate Units: meters, Altitude: height above mean sea level (MSL) – meters.
- Accuracy to Datum – 3.05 meters
- Data Collection Method:

Survey grade GPS : Post Processed Differential _____
 Real-Time Differential

Mapping Grade GPS _____ : Post Processed Differential _____
 Real-Time Differential _____

- Letter size copy of the topography map showing the well location.**

I the undersigned, hereby certify this data is correct to the best of my knowledge and belief and shows all the information required by law and the regulations issued and prescribed by the Office of Oil and Gas.

Project Manager 12-3-20
 Signature Title Date

03/19/2021

RECEIVED
Office of Oil and Gas


DEC 10 2020

WV Department of
Environmental Protection

4704901707P



◆ Well Location
□ Limit of Disturbance

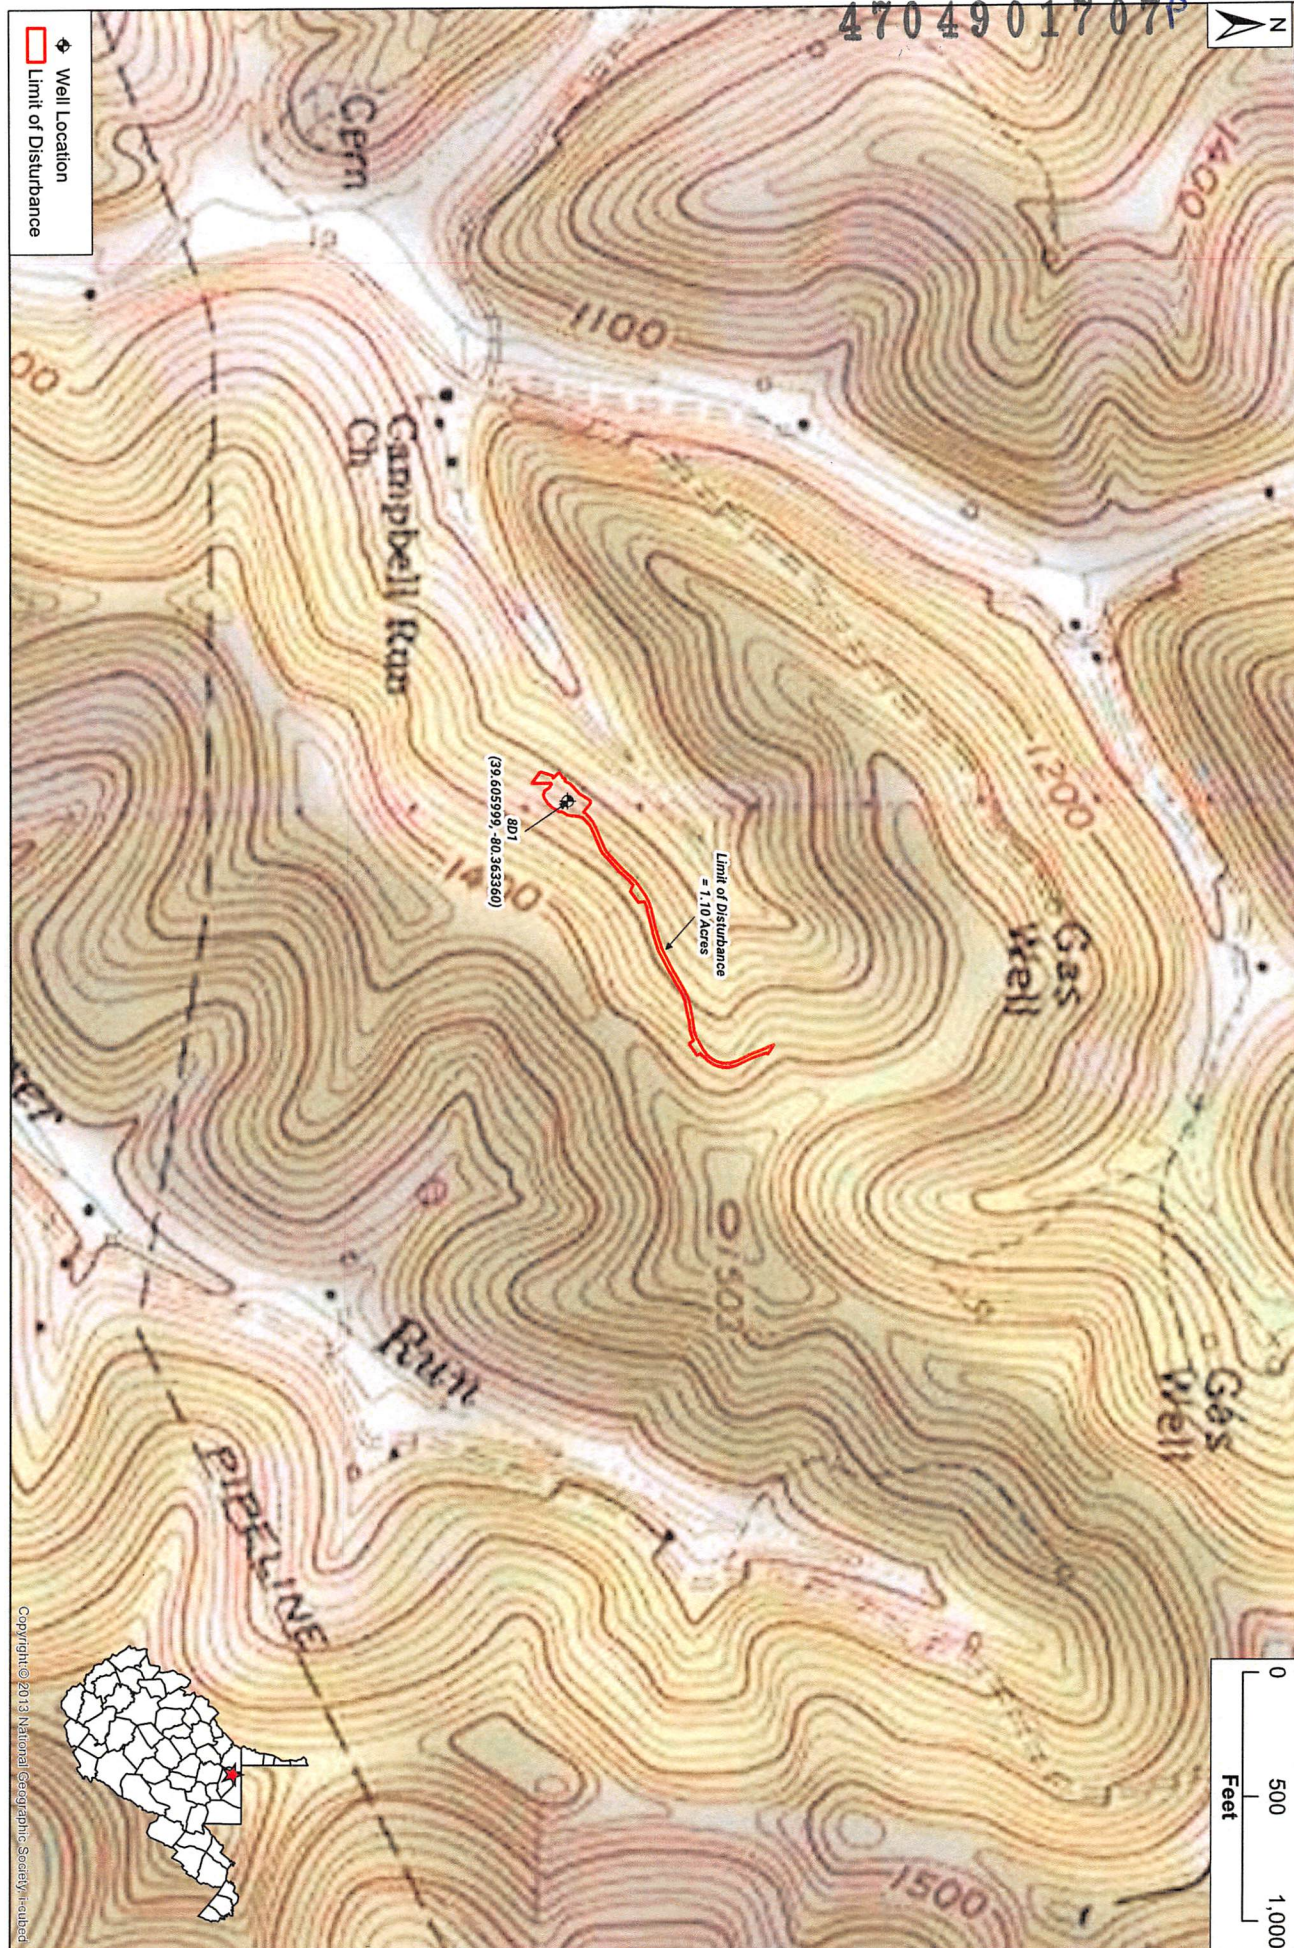

Copyright © 2013 National Geographic Society, Inc.

Date: 11/19/21
By: J. Stasak



8D1 CCR Well Head
Site Location Topographic Map
Marion Countv. West Virginia



03/19/2021