



West Virginia Department of Environmental Protection
Office of Oil and Gas
WELL LOCATION FORM: GPS

API: 47-049-02278 WELL NO.: Michael 1H

FARM NAME: Michael

RESPONSIBLE PARTY NAME: EQT Production Company

COUNTY: Marion DISTRICT: Mannington

QUADRANGLE: Glover Gap 7.5'

RECEIVED
Office of Oil & Gas

AUG 17 2022

SURFACE OWNER: Juanita O. Michael & William J. Michael

WV Department of
Environmental Protection

ROYALTY OWNER: Hayes, et al.

UTM GPS NORTHING: 4378562

UTM GPS EASTING: 550369 GPS ELEVATION: 425 m (1394 ft)

The Responsible Party named above has chosen to submit GPS coordinates in lieu of preparing a new well location plat for a plugging permit or assigned API number on the above well. The Office of Oil and Gas will not accept GPS coordinates that do not meet the following requirements:

1. Datum: NAD 1983, Zone: 17 North, Coordinate Units: meters, Altitude: height above mean sea level (MSL) – meters.
2. Accuracy to Datum – 3.05 meters
3. Data Collection Method:

Survey grade GPS _____ : Post Processed Differential _____
 Real-Time Differential _____
 Mapping Grade GPS X : Post Processed Differential X
 Real-Time Differential _____

4. **Letter size copy of the topography map showing the well location.**

I the undersigned, hereby certify this data is correct to the best of my knowledge and belief and shows all the information required by law and the regulations issued and prescribed by the Office of Oil and Gas.


Ben R. Stoltz
Signature

P.S. 2092
Title

8-17-22
Date

4704902218T
49-02278

No Water - Access Road Marked

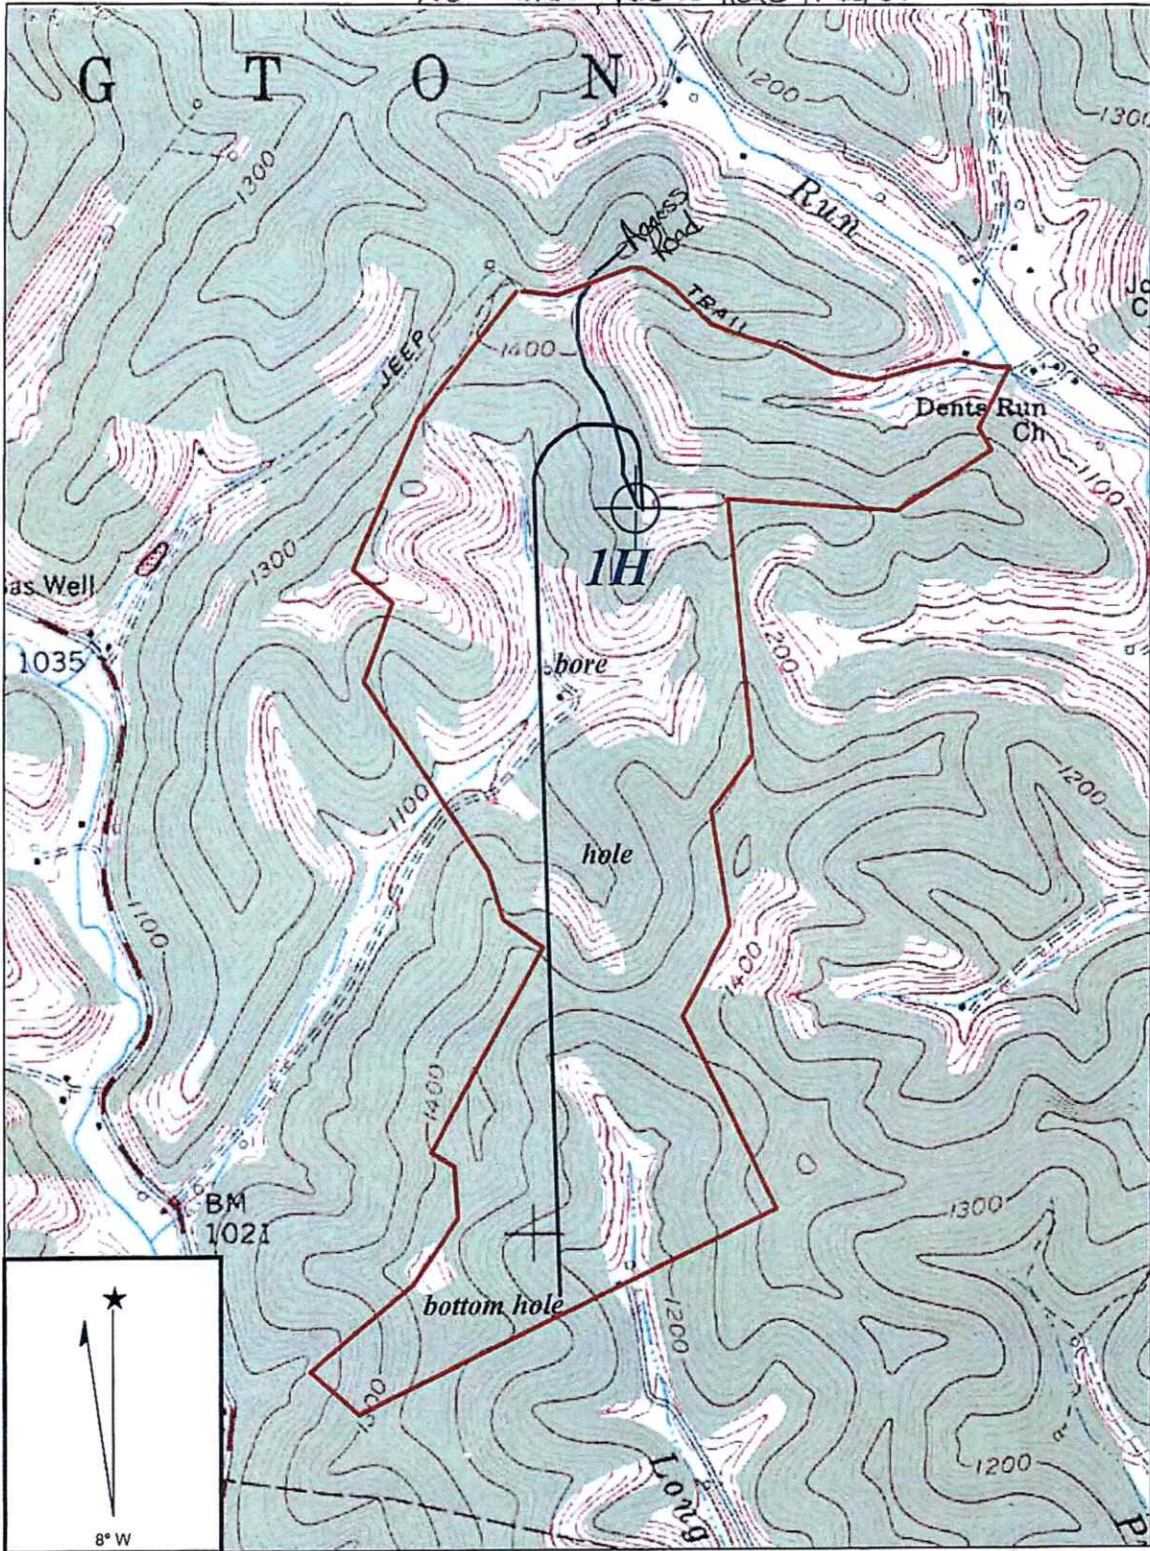

Copyright (C) 1997, Maptech, Inc.

GLOVER GAP QUADRANGLE

SCALE 1" = 1000'

TRANS ENERGY, INC.

WELL: MICHAEL 1 H
MICHAEL, ET AL +/- 386.5 ACRE UNIT

MANNINGTON DISTRICT MARION COUNTY WEST VIRGINIA

WRH
10-17-13

RECEIVED
Office of Oil and Gas
OCT 22 2013

RECEIVED
Office of Oil and Gas
JUL 28 2022

WV Department of Environmental Protection
WV Department of Environmental Protection

03/14/2010 08/19/2022