



West Virginia Department of Environmental Protection
Office of Oil and Gas
WELL LOCATION FORM: GPS

API: 47-049-02279 WELL NO.: Michael 2H

FARM NAME: Michael

RESPONSIBLE PARTY NAME: EQT Production Company

COUNTY: Marion DISTRICT: Mannington

QUADRANGLE: Glover Gap 7.5'

RECEIVED
Office of Oil & Gas
AUG 17 2022

SURFACE OWNER: Juanita O. Michael & William J. Michael

WV Department of
Environmental Protection

ROYALTY OWNER: Hayes, et al.

UTM GPS NORTHING: 4378565

UTM GPS EASTING: 550364 GPS ELEVATION: 424 m (1392 ft)

The Responsible Party named above has chosen to submit GPS coordinates in lieu of preparing a new well location plat for a plugging permit or assigned API number on the above well. The Office of Oil and Gas will not accept GPS coordinates that do not meet the following requirements:

- Datum: NAD 1983, Zone: 17 North, Coordinate Units: meters, Altitude: height above mean sea level (MSL) – meters.
- Accuracy to Datum – 3.05 meters
- Data Collection Method:

Survey grade GPS _____ : Post Processed Differential _____
 Real-Time Differential _____
 Mapping Grade GPS X : Post Processed Differential X
 Real-Time Differential _____

- Letter size copy of the topography map showing the well location.**

I the undersigned, hereby certify this data is correct to the best of my knowledge and belief and shows all the information required by law and the regulations issued and prescribed by the Office of Oil and Gas.


Bar R. Stoltz
Signature

P.S. 2092
Title

8-17-22
Date

47 n 49 02 2 / 9 P
49-02279

No Water, Access Road

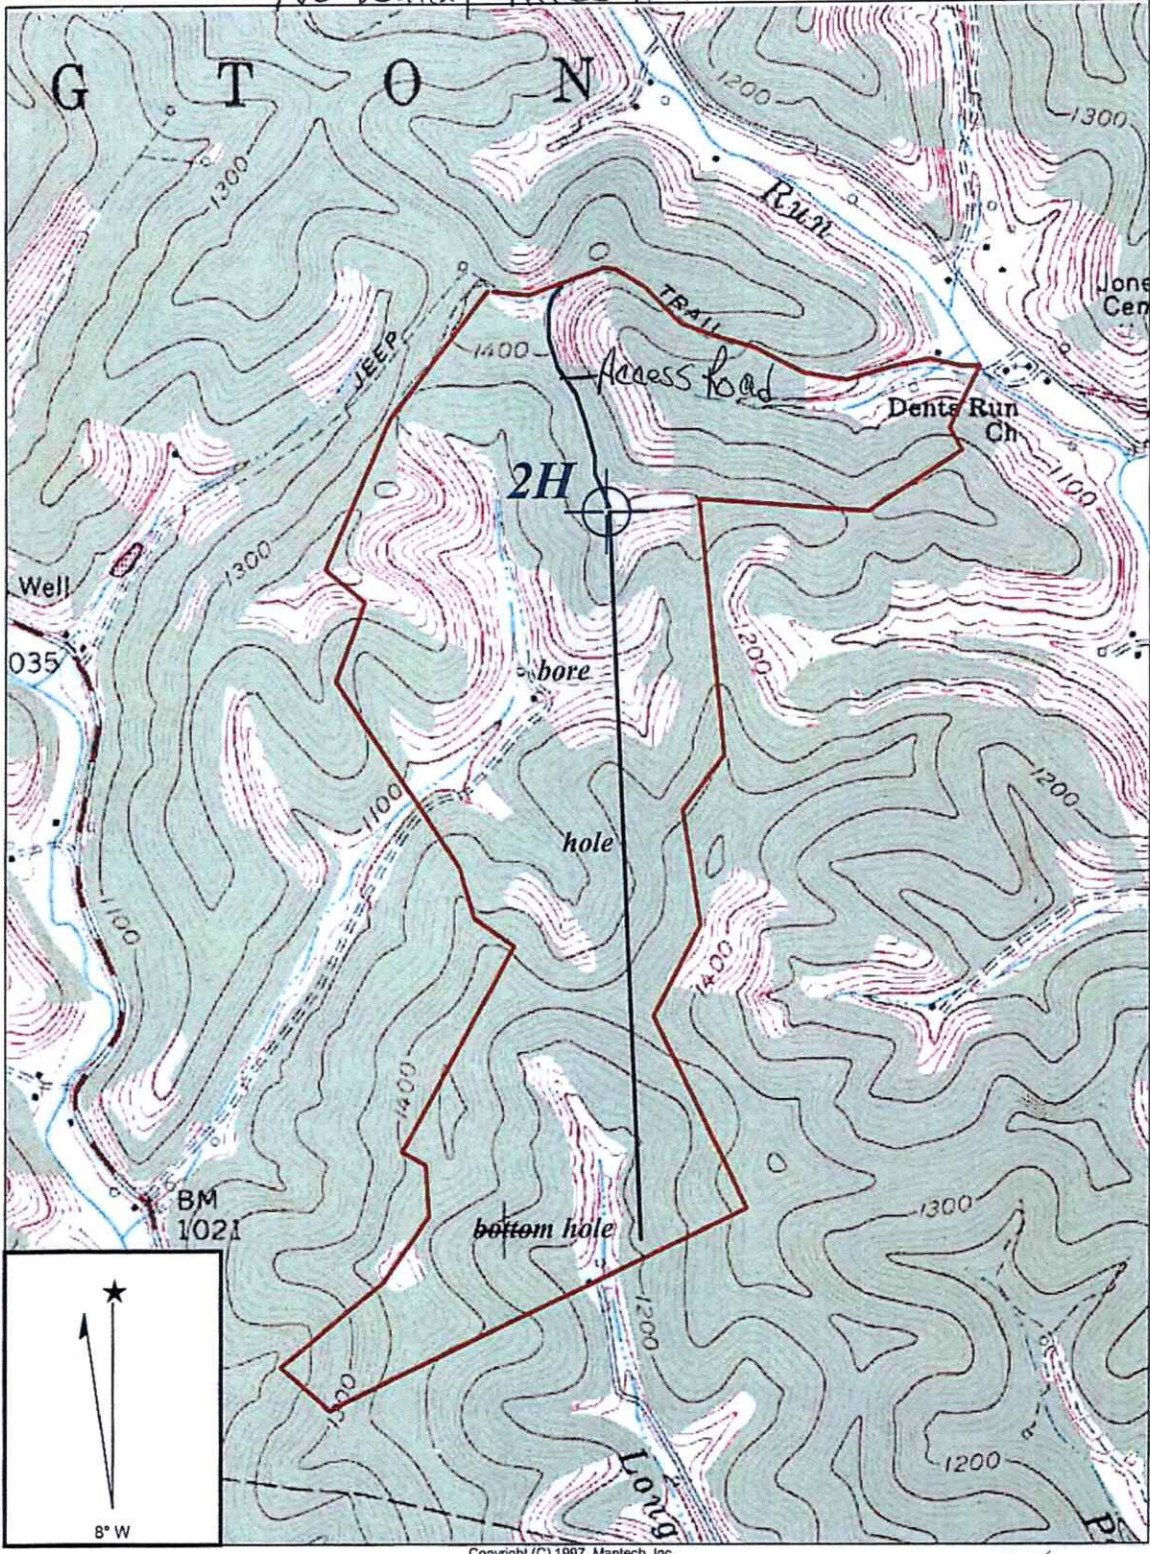

GLOVER GAP QUADRANGLE

SCALE 1" = 1000'

TRANS ENERGY, INC.

WELL: MICHAEL 2 H
MICHAEL, ET AL +/- 386.5 ACRE UNIT

MANNINGTON DISTRICT MARION COUNTY WEST VIRGINIA

WRH
10-17-13

RECEIVED
Office of Oil and Gas

JUL 28 2022

RECEIVED
Office of Oil and Gas WV Department of
Environmental Protection
OCT 29 2013

WV Department of
Environmental Protection
03/17/2014-08/19/2022