

WW-7  
8-30-06



West Virginia Department of Environmental Protection  
Office of Oil and Gas  
**WELL LOCATION FORM: GPS**

API: 47-049-02284 WELL NO.: Jones 4H

FARM NAME: Jones

RESPONSIBLE PARTY NAME: EQT Production Company

COUNTY: Marion DISTRICT: Mannington

QUADRANGLE: Glover Gap 7.5'

SURFACE OWNER: Jason and Michelle Stout

ROYALTY OWNER: Robert Jones, et al.

UTM GPS NORTHING: 4381936

UTM GPS EASTING: 549197 GPS ELEVATION: 345 m (1135 ft)

The Responsible Party named above has chosen to submit GPS coordinates in lieu of preparing a new well location plat for a plugging permit or assigned API number on the above well. The Office of Oil and Gas will not accept GPS coordinates that do not meet the following requirements:

1. Datum: NAD 1983, Zone: 17 North, Coordinate Units: meters, Altitude: height above mean sea level (MSL) – meters.
2. Accuracy to Datum – 3.05 meters
3. Data Collection Method:

Survey grade GPS  X : Post Processed Differential  X   
Real-Time Differential \_\_\_\_\_

Mapping Grade GPS \_\_\_\_\_: Post Processed Differential \_\_\_\_\_  
Real-Time Differential \_\_\_\_\_

4. **Letter size copy of the topography map showing the well location.**

I the undersigned, hereby certify this data is correct to the best of my knowledge and belief and shows all the information required by law and the regulations issued and prescribed by the Office of Oil and Gas.

Ben R. Stoltz  
Signature

P.S. 2092  
Title

2-4-22  
Date

RECEIVED  
Office of Oil and Gas  
JUL 28 2022  
WV Department of  
Environmental Protection

08/19/2022

Topo Quad: Glover Gap 7.5' Scale: 1" = 2000'

County: Marion Date: February 4, 2022

District: Mannington Project No: 74-18-00-08

# Jones 4H (47-049-02284)

Topo



**NAD 27, North Zone**  
**N:396,766.173**  
**E:1,738,656.033**

**WGS 84**  
**LAT:39.585735**  
**LONG:-80.427102**  
**ELEV:1135.64'**



SURVEYING AND MAPPING SERVICES PERFORMED BY:  
**ALLEGHENY SURVEYS, INC.**  
 1-800-482-8606  
 237 Birch River Road  
 Birch River, WV 26610  
 PH: (304) 649-8606  
 FAX: (304) 649-8608


PREPARED FOR:  
**EQT Production Company**

400 Woodcliff Drive  
 Canonsburg, PA 15317

RECEIVED  
 JUL 28 2022  
 WV Department of  
 Environmental Affairs

06/19/2022



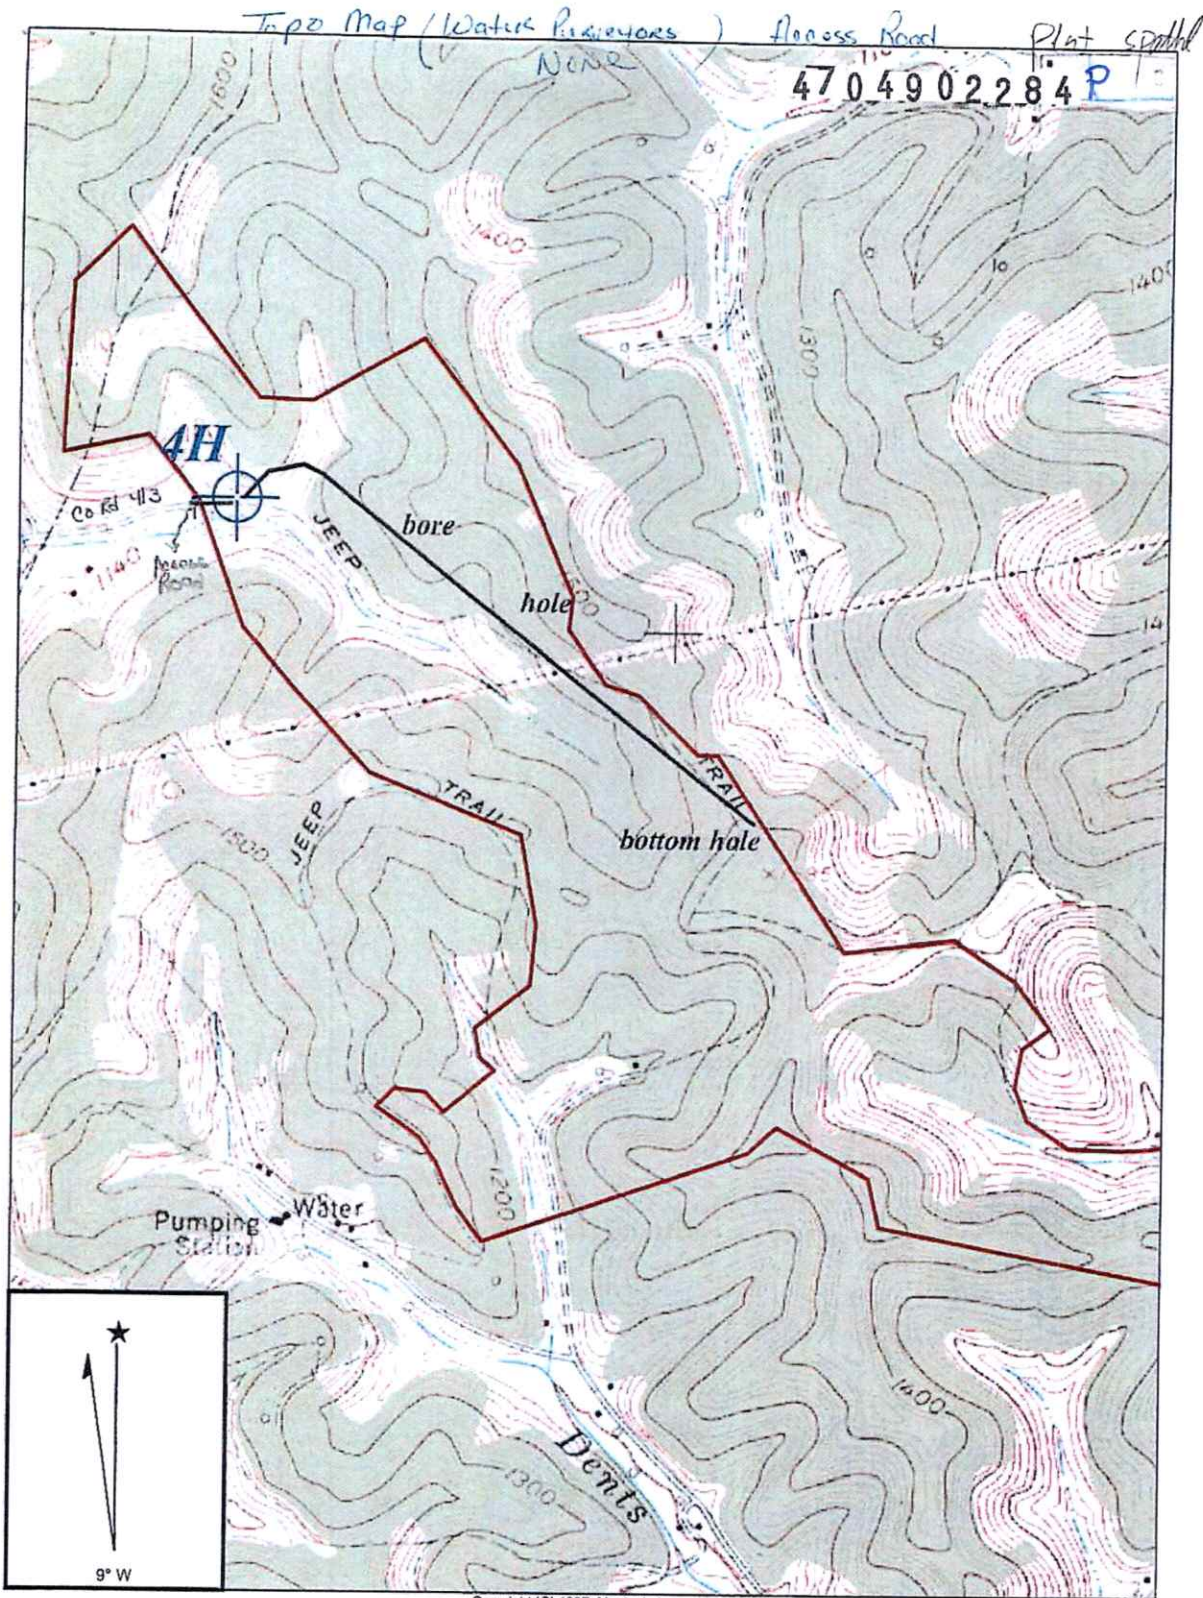

Copyright (C) 1997, Maptech, Inc.

**GLOVER GAP QUADRANGLE**

SCALE 1" = 1000'

**TRANS ENERGY, INC.**

WELL: JONES 4H  
R. JONES, ET AL 411.355 ACRE UNIT

MANNINGTON DISTRICT MARION COUNTY WEST VIRGINIA

*WRH*  
*11-13-13*

Received

NOV 29

RECEIVED  
Office of Oil and Gas  
JUL 28 2022  
WV Department of  
Environmental Protection  
Office of Oil and Gas  
WV Dept. of Environmental Protection

04/18/2014 08/19/2022