




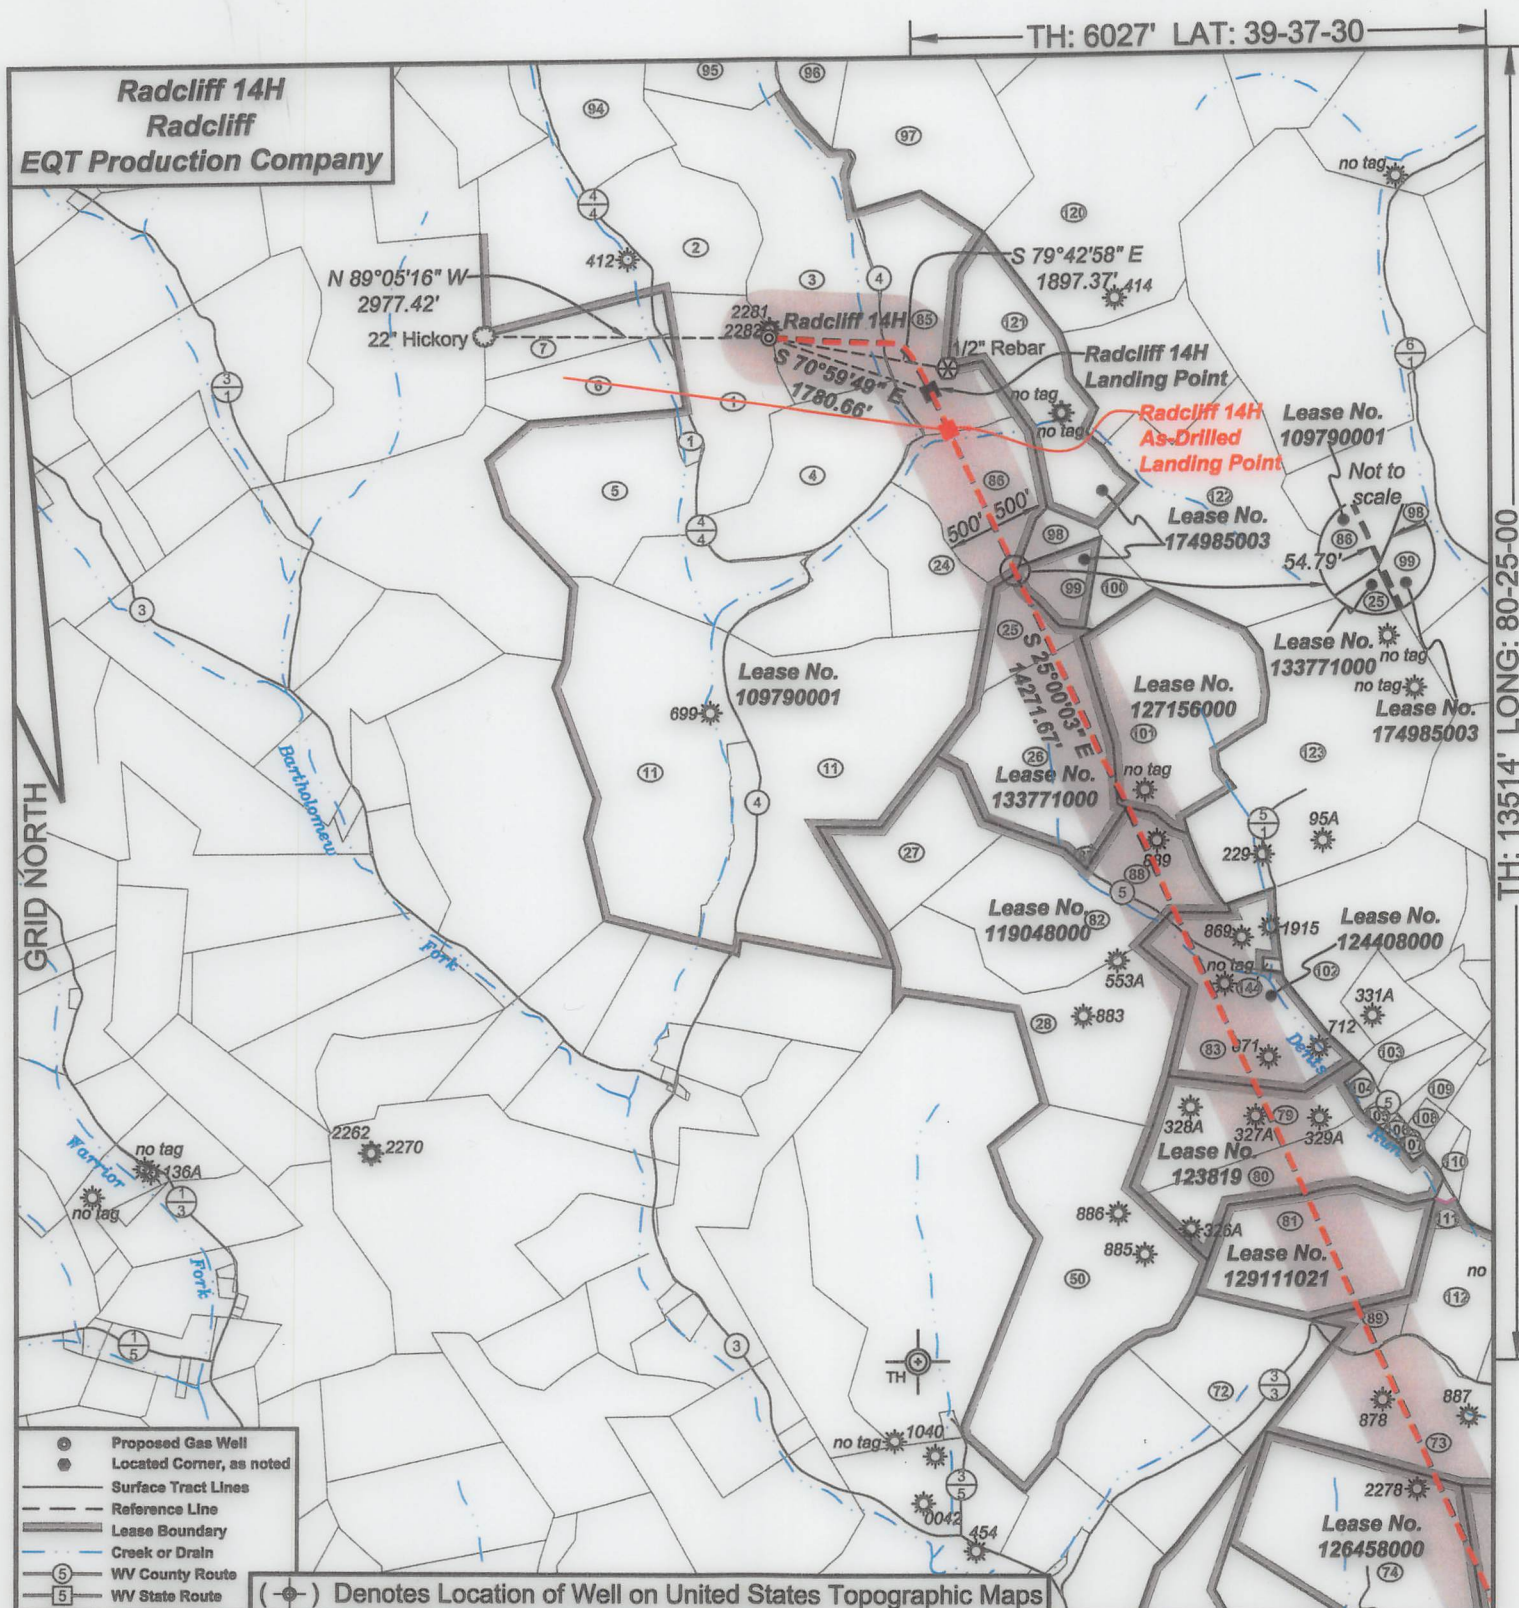

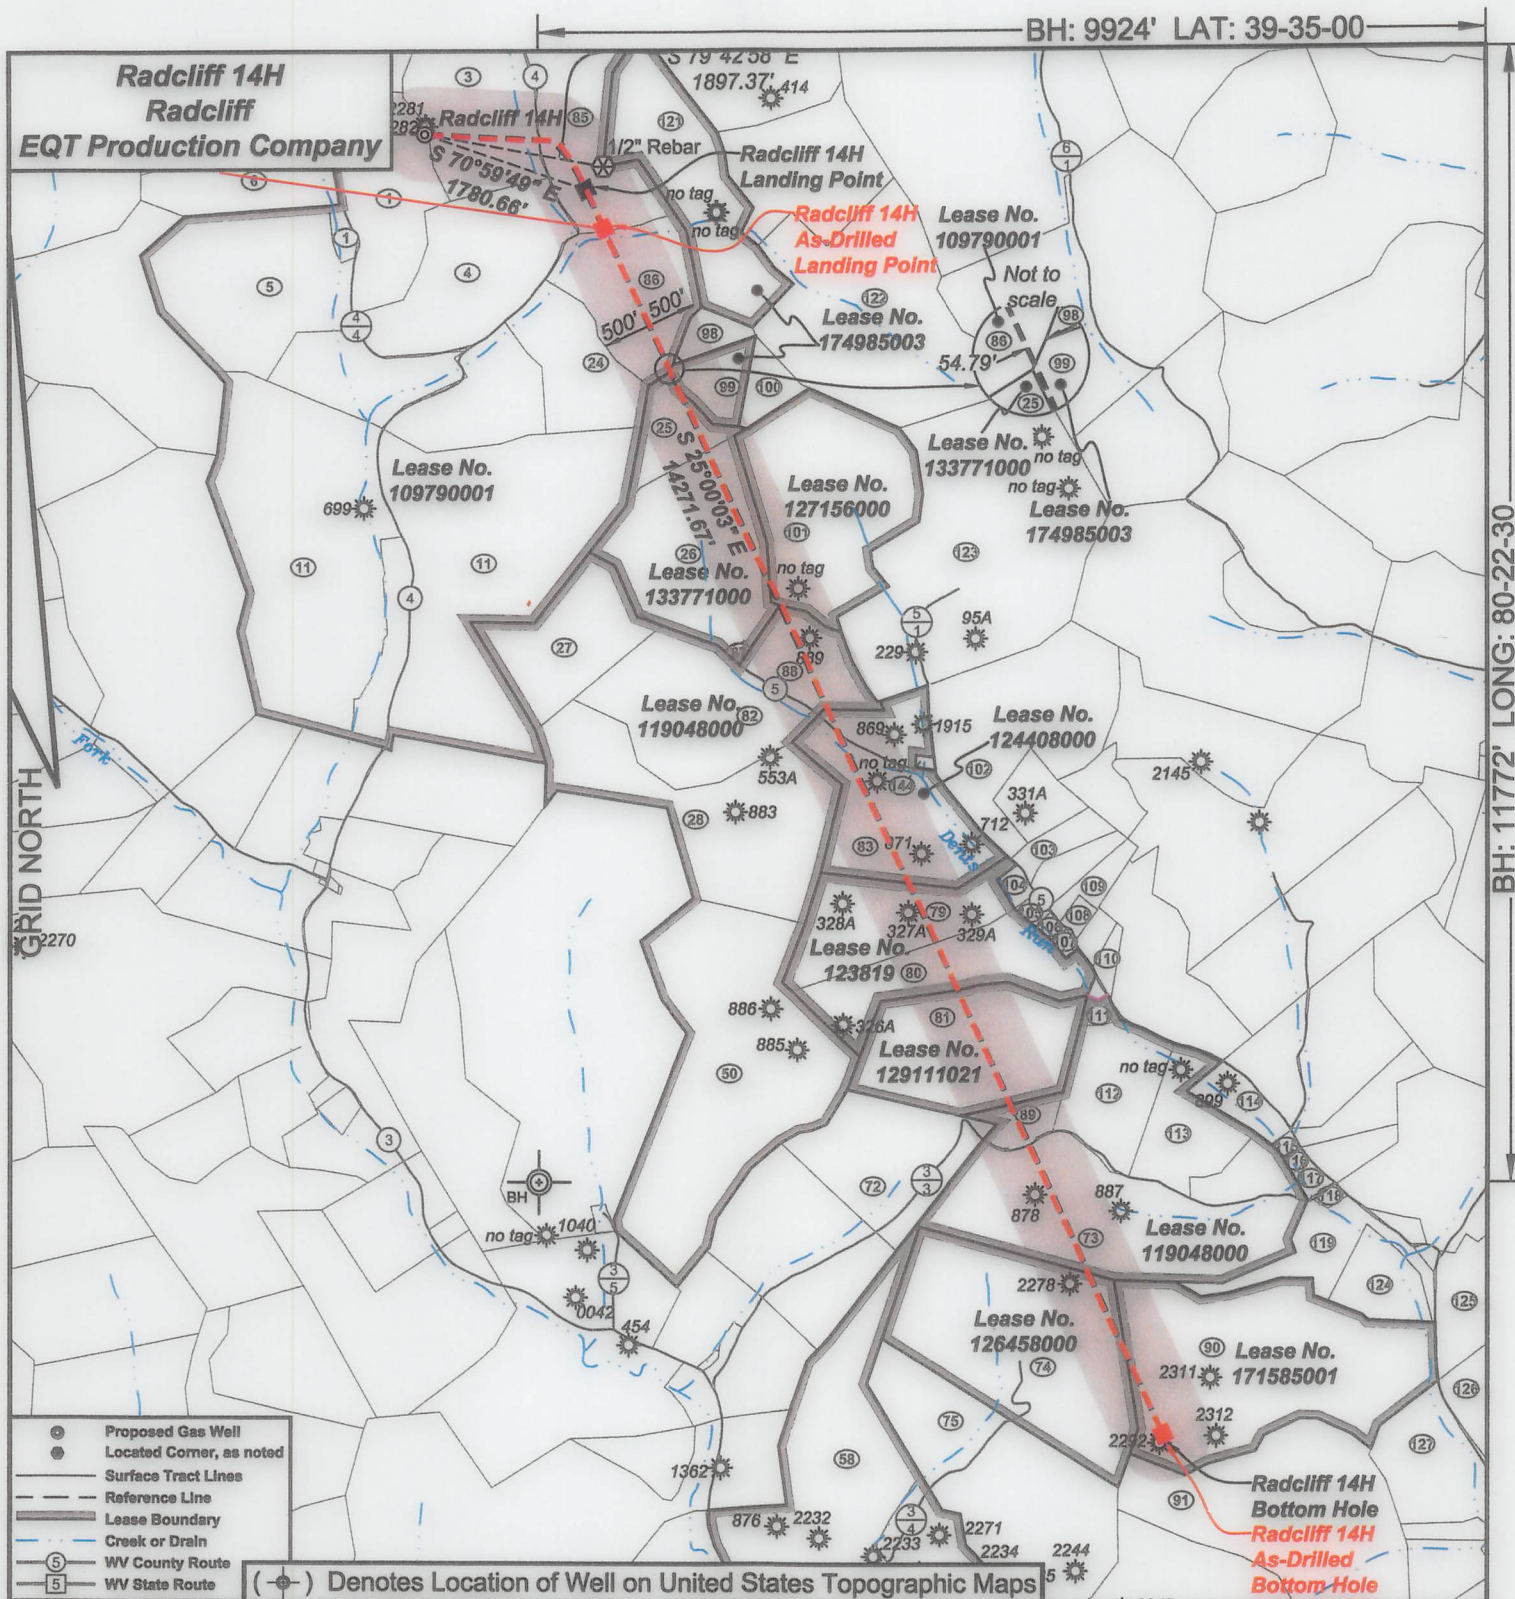

Radcliff 14H  
Radcliff  
EQT Production Company

| Tract I.D. | Tax Map No. | Parcel No. | County | District   | Surface Tract Owner                  | Acres   |
|------------|-------------|------------|--------|------------|--------------------------------------|---------|
| 1          | 40          | 10.1       | Marion | Mannington | Jackie D. & Sheila L. Radcliff       | 48.08   |
| 2          | 40          | 10         | Marion | Mannington | Shelly L. Nelson                     | 43.03   |
| 3          | 40          | 3          | Marion | Mannington | Jason G. & Heather R. Stout          | 99.75   |
| 4          | 40          | 2          | Marion | Mannington | Lula B. Knight                       | 56.32   |
| 5          | 40          | 11         | Marion | Mannington | Clarence W. Sweeney                  | 63      |
| 6          | 40          | 12         | Marion | Mannington | Jackie D. & Sheila L. Radcliff       | 27.35   |
| 7          | 40          | 13         | Marion | Mannington | Shelly L. Nelson                     | 19.75   |
| 11         | 39          | 4          | Marion | Mannington | Coastal Forest Resources Company     | 245.722 |
| 24         | 40          | 2.1        | Marion | Mannington | Jason G. & Heather R. Stout          | 29.58   |
| 25         | 39          | 3          | Marion | Mannington | Thomas G. & Theresa A. Jones         | 10.75   |
| 26         | 39          | 5          | Marion | Mannington | Thomas G. & Theresa A. Jones         | 61.85   |
| 27         | 38          | 21.3       | Marion | Mannington | David Maffield                       | 37.292  |
| 28         | 38          | 21         | Marion | Mannington | Dennis G. & Louise M. Hayes          | 71.885  |
| 50         | 38          | 11         | Marion | Mannington | Yulia Nikitenko                      | 115     |
| 58         | 37          | 22         | Marion | Mannington | Jeffrey H. Michael                   | 166.83  |
| 72         | 38          | 14.1       | Marion | Mannington | John A. Meyhus, Jr.                  | 48      |
| 73         | 37          | 34         | Marion | Mannington | James D. Atkinson                    | 112.5   |
| 74         | 37          | 23         | Marion | Mannington | Christine L. Fragale, et al.         | 95      |
| 75         | 37          | 24         | Marion | Mannington | Jeffrey H. Michael                   | 79      |
| 79         | 38          | 19         | Marion | Mannington | Dorothy D. Hendershot                | 98.246  |
| 80         | 38          | 19.4       | Marion | Mannington | William F. Hendershot                | 91.707  |
| 81         | 38          | 15         | Marion | Mannington | Michael & Julia A. Billie            | 58.67   |
| 82         | 38          | 21.2       | Marion | Mannington | Douglas E. & Debora L. Maffield      | 54.669  |
| 83         | 38          | 20         | Marion | Mannington | Dennis G. & Louise M. Hayes          | 59.24   |
| 85         | 26          | 16         | Marion | Mannington | Jason G. & Heather R. Stout          | 48.12   |
| 86         | 39          | 2          | Marion | Mannington | Lula B. Knight                       | 43.99   |
| 87         | 39          | 6          | Marion | Mannington | Thomas G. & Theresa A. Jones         | 0.66    |
| 88         | 38          | 21.1       | Marion | Mannington | Ronald & Jean Hayes                  | 21.55   |
| 89         | 38          | 16         | Marion | Mannington | Michael & Julia A. Billie            | 7.65    |
| 90         | 37          | 31         | Marion | Mannington | Marion County Coal Resources Inc.    | 109.2   |
| 91         | 37          | 30         | Marion | Mannington | Marion County Coal Resources Inc.    | 107     |
| 94         | 40          | 9          | Marion | Mannington | Karl A. Gouze                        | 35.32   |
| 95         | 40          | 4          | Marion | Mannington | EBX-EM LLC                           | 20.8    |
| 96         | NA          | NA         | Marion | Mannington | Tax Info Not Available               | NA      |
| 97         | 26          | 15         | Marion | Mannington | Jason G. & Michelle R. Stout         | 91.9    |
| 98         | 39          | 15         | Marion | Mannington | Jason G. & Michelle R. Stout         | 7.5     |
| 99         | 26          | 17         | Marion | Mannington | Jason G. & Michelle R. Stout         | 57      |
| 100        | 39          | 16         | Marion | Mannington | Jason G. & Michelle R. Stout         | 7.351   |
| 101        | 39          | 7          | Marion | Mannington | Dennis Maffel & John Pheasant        | 84      |
| 102        | 39          | 9          | Marion | Mannington | Dennis Maffel & John Pheasant        | 62.5    |
| 103        | 39          | 11.2       | Marion | Mannington | Michael F. & Kerri Berthy            | 7.01    |
| 104        | 38          | 19.2       | Marion | Mannington | Dorothy D. Hendershot                | 2.245   |
| 105        | 38          | 19.5       | Marion | Mannington | Dorothy D. Hendershot                | 1.456   |
| 106        | 38          | 19.3       | Marion | Mannington | Robin R. Smith & James W. Hendershot | 1.01    |
| 107        | 38          | 19.1       | Marion | Mannington | David A. Wright                      | 1.17    |
| 108        | 39          | 11.1       | Marion | Mannington | Kerry Orloff & Michael Berthy        | 1.92    |
| 109        | 39          | 11.3       | Marion | Mannington | Kerri F. & Michael F. Berthy         | 9.11    |
| 110        | 30          | 11.4       | Marion | Mannington | Lynn E. Sturm                        | 2.73    |
| 111        | 38          | 18         | Marion | Mannington | William D. Crouser                   | 0.25    |
| 112        | 38          | 17         | Marion | Mannington | Henry H. Gill, et al.                | 26.58   |
| 113        | 38          | 17.1       | Marion | Mannington | Douglas L. & Kimberly J. Cyphers     | 24.8    |
| 114        | 36          | 3          | Marion | Mannington | Douglas L. Cyphers                   | 24.24   |
| 115        | 36          | 5          | Marion | Mannington | Douglas L. Cyphers                   | 1.55    |
| 116        | 36          | 6          | Marion | Mannington | Douglas L. Cyphers                   | 1.065   |
| 117        | 36          | 6.1        | Marion | Mannington | Douglas L. & Kimberly J. Cyphers     | 1.935   |
| 118        | 37          | 33         | Marion | Mannington | Dents Run Baptist Church             | 1.31    |
| 119        | 37          | 32         | Marion | Mannington | Mark A. & Carrie A. Hendershot       | 14.31   |
| 120        | 26          | 12         | Marion | Mannington | EBX-EM LLC                           | 152.25  |
| 121        | 26          | 17         | Marion | Mannington | Jason G. & Michelle R. Stout         | 57      |
| 122        | 39          | 1          | Marion | Mannington | Albert C. Woods Helms                | 90.6    |
| 123        | 39          | 8          | Marion | Mannington | Dennis Maffel & John Pheasant        | 128.635 |
| 124        | 37          | 32.2       | Marion | Mannington | Marion County Coal Resources Inc.    | 14.69   |
| 125        | 36          | 15         | Marion | Mannington | Mark A. & Carrie A. Hendershot       | 24      |
| 126        | 36          | 16         | Marion | Mannington | Marion County Coal Resources Inc.    | 60.11   |
| 127        | 36          | 17         | Marion | Mannington | Marion County Coal Resources Inc.    | 35      |
| 144        | 38          | 20.1       | Marion | Mannington | Donald Malone                        | 0.5     |

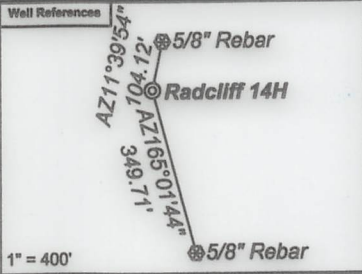


As-Drilled Well Information:  
Radcliff 14H coordinates are  
NAD 83 N: 397,624.10 E: 1,704,139.36  
NAD 83 UTM N: 4,382,170.48 E: 548,254.80  
Radcliff 14H Landing Point coordinates are  
NAD 83 N: 396,639.03 E: 1,706,014.63  
NAD 83 UTM N: 4,381,879.90 E: 548,831.13  
Radcliff 14H Bottom Hole coordinates are  
NAD 83 N: 384,110.50 E: 1,711,852.69  
NAD 83 UTM N: 4,378,092.60 E: 550,673.48  
West Virginia Coordinate system of 1983 (North Zone)  
based upon Differential GPS Measurements.  
Plat orientation, corner and well ties are based upon  
the grid north meridian.  
Well location references are based upon the grid north  
meridian.  
UTM coordinates are NAD83, Zone 17, Meters.

Radcliff


Radcliff 18H ©  
Radcliff 16H ©  
Radcliff 14H ©  
Radcliff 12H ©  
Radcliff 10H ©  
Radcliff 8H ©  
Radcliff 6H ©  
Radcliff 4H ©

| Lease No. | Owner                                        | Acres  |
|-----------|----------------------------------------------|--------|
| 109790001 | Rebecca R. Shuttlesworth, et al.             | 1090   |
| 174985003 | Country Roads Minerals, LLC, et al.          | 59     |
| 133771000 | Bounty Minerals LLC, et al.                  | 72.75  |
| 127156000 | EQT Production Company, et al.               | 84     |
| 119048000 | Lee and Hall Royalties, et al.               | 809    |
| 124408000 | MCJV Holdings, LLC, et al.                   | 59.75  |
| 123819    | XTO Energy, Inc.                             | 77.948 |
| 129111021 | Jeffrey Louis Huey, et al.                   | 58.67  |
| 126458000 | Melania Higginbotham Arevalo de Brol, et al. | 95     |
| 171585001 | Country Roads Minerals, LLC, et al.          | 109.42 |

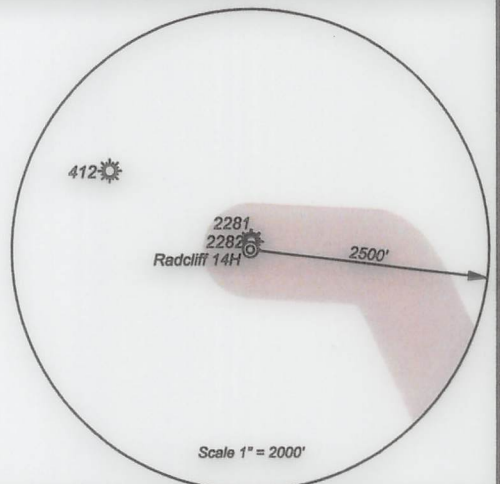

I, the undersigned, hereby certify that this plat is correct to the best of my knowledge and belief and shows all the information required by law and the regulations issued and prescribed by the Department of Environmental Protection.

*Ben R. Singleton*  
P.S. 2092

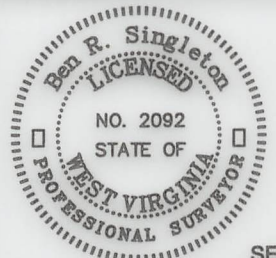

SEAL

FILE NO: 113-21  
DRAWING NO: Radcliff 14H  
SCALE: 1" = 2000'  
MINIMUM DEGREE OF ACCURACY: 1:2500  
PROVEN SOURCE OF ELEVATION: NGS CORS Station

STATE OF WEST VIRGINIA  
DEPARTMENT OF ENVIRONMENTAL PROTECTION  
OIL AND GAS DIVISION



DATE: April 18 20 24  
OPERATOR'S WELL NO.: Radcliff 14H  
API WELL NO  
47 - 049 - 02513  
STATE COUNTY PERMIT

WELL TYPE: ☐ OIL ☒ GAS ☐ LIQUID INJECTION ☐ WASTE DISPOSAL  
(IF GAS) PRODUCTION: ☐ STORAGE ☐ DEEP ☒ SHALLOW  
LOCATION: ELEVATION: 1493' WATERSHED Bartholomew Fork QUADRANGLE: Glover Gap  
DISTRICT: Mannington COUNTY: Marion  
SURFACE OWNER: Jackie D. & Sheila L. Radcliff ACREAGE: 48.08  
ROYALTY OWNER: Rebecca R. Shuttlesworth, et al. LEASE NO: 109790001 ACREAGE: 1090  
PROPOSED WORK: ☒ DRILL ☐ CONVERT ☐ DRILL DEEPER ☒ FRACTURE OR STIMULATE ☐ PLUG OFF OLD FORMATION  
☐ PERFORATE NEW FORMATION ☐ OTHER PHYSICAL CHANGE IN WELL (SPECIFY)  
☐ PLUG AND ABANDON ☐ CLEAN OUT AND REPLUG TARGET FORMATION: Marcellus ESTIMATED DEPTH: 7916'

WELL OPERATOR: EQT Production Company DESIGNATED AGENT: Joseph C. Mallow  
ADDRESS: 400 Woodcliff Drive ADDRESS: 427 Midstate Drive  
Canonsburg, PA 15317 Clarksburg, WV 26301