


TH: 6018' LAT: 39-37-30


**Radcliff 8H
Radcliff
EQT Production Company**

CURVE	RADIUS	ARC LENGTH	CHORD BEARING	CHORD LENGTH
C1	399.15'	275.89'	S 69°18'01" W	270.43'

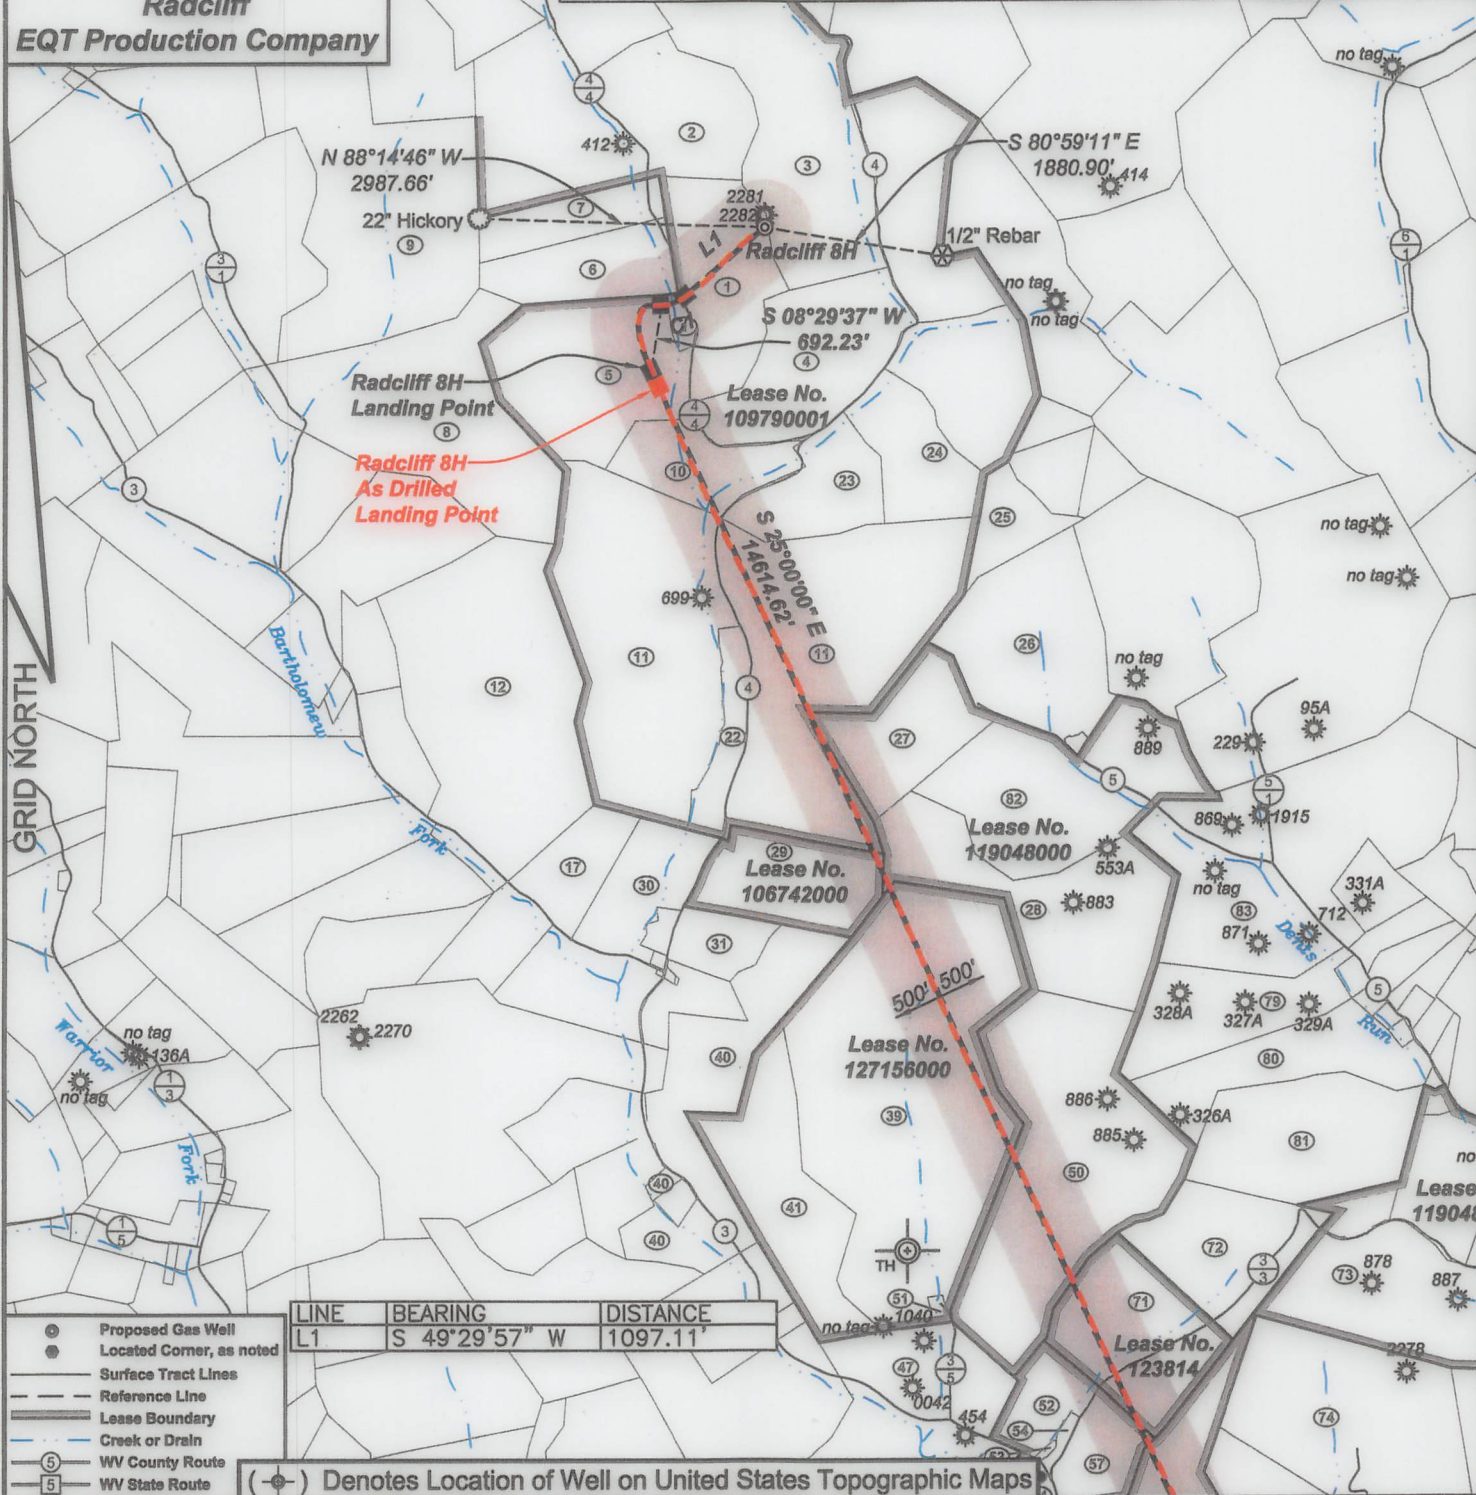

I, the undersigned, hereby certify that this plat is correct to the best of my knowledge and belief and shows all the information required by law and the regulations issued and prescribed by the Department of Environmental Protection.

B. R. S. S.
P.S. 2092

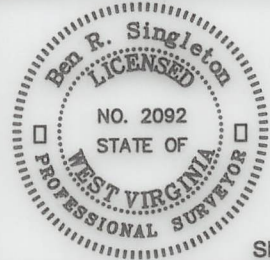

SEAL

FILE NO: 113-21
DRAWING NO: Radcliff 8H
SCALE: 1" = 2000'
MINIMUM DEGREE OF ACCURACY:
1:2500
PROVEN SOURCE OF ELEVATION:
NGS CORS Station

STATE OF WEST VIRGINIA
DEPARTMENT OF ENVIRONMENTAL PROTECTION
OIL AND GAS DIVISION


DATE: March 21 2024
 OPERATOR'S WELL NO.: Radcliff 8H
 API WELL NO
47 - 049 - 02518
 STATE COUNTY PERMIT

WELL TYPE: ☐ OIL ☒ GAS ☐ LIQUID INJECTION ☐ WASTE DISPOSAL
(IF GAS) PRODUCTION: ☐ STORAGE ☐ DEEP ☒ SHALLOW
LOCATION: ELEVATION: 1493' WATERSHED Bartholomew Fork QUADRANGLE: Glover Gap
DISTRICT: Mannington COUNTY: Marion **04/11/2025**
SURFACE OWNER: Jackie D. & Sheila L. Radcliff ACREAGE: 48.08
ROYALTY OWNER: Rebecca R. Shuttlesworth, et al. LEASE NO: 109790001 ACREAGE: 1090
PROPOSED WORK: ☒ DRILL ☐ CONVERT ☐ DRILL DEEPER ☒ FRACTURE OR STIMULATE ☐ PLUG OFF OLD FORMATION
☐ PERFORATE NEW FORMATION ☐ OTHER PHYSICAL CHANGE IN WELL (SPECIFY) _____
☐ PLUG AND ABANDON ☐ CLEAN OUT AND REPLUG TARGET FORMATION: Marcellus ESTIMATED DEPTH: 7916'

WELL OPERATOR: <u>EQT Production Company</u>	DESIGNATED AGENT: <u>Joseph C. Mallow</u>
ADDRESS: <u>400 Woodcliff Drive</u>	ADDRESS: <u>427 Midstate Drive</u>
<u>Canonsburg, PA 15317</u>	<u>Clarksburg, WV 26301</u>

BH: 881' LAT: 39-35-00


Radcliff 8H
Radcliff
EQT Production Company

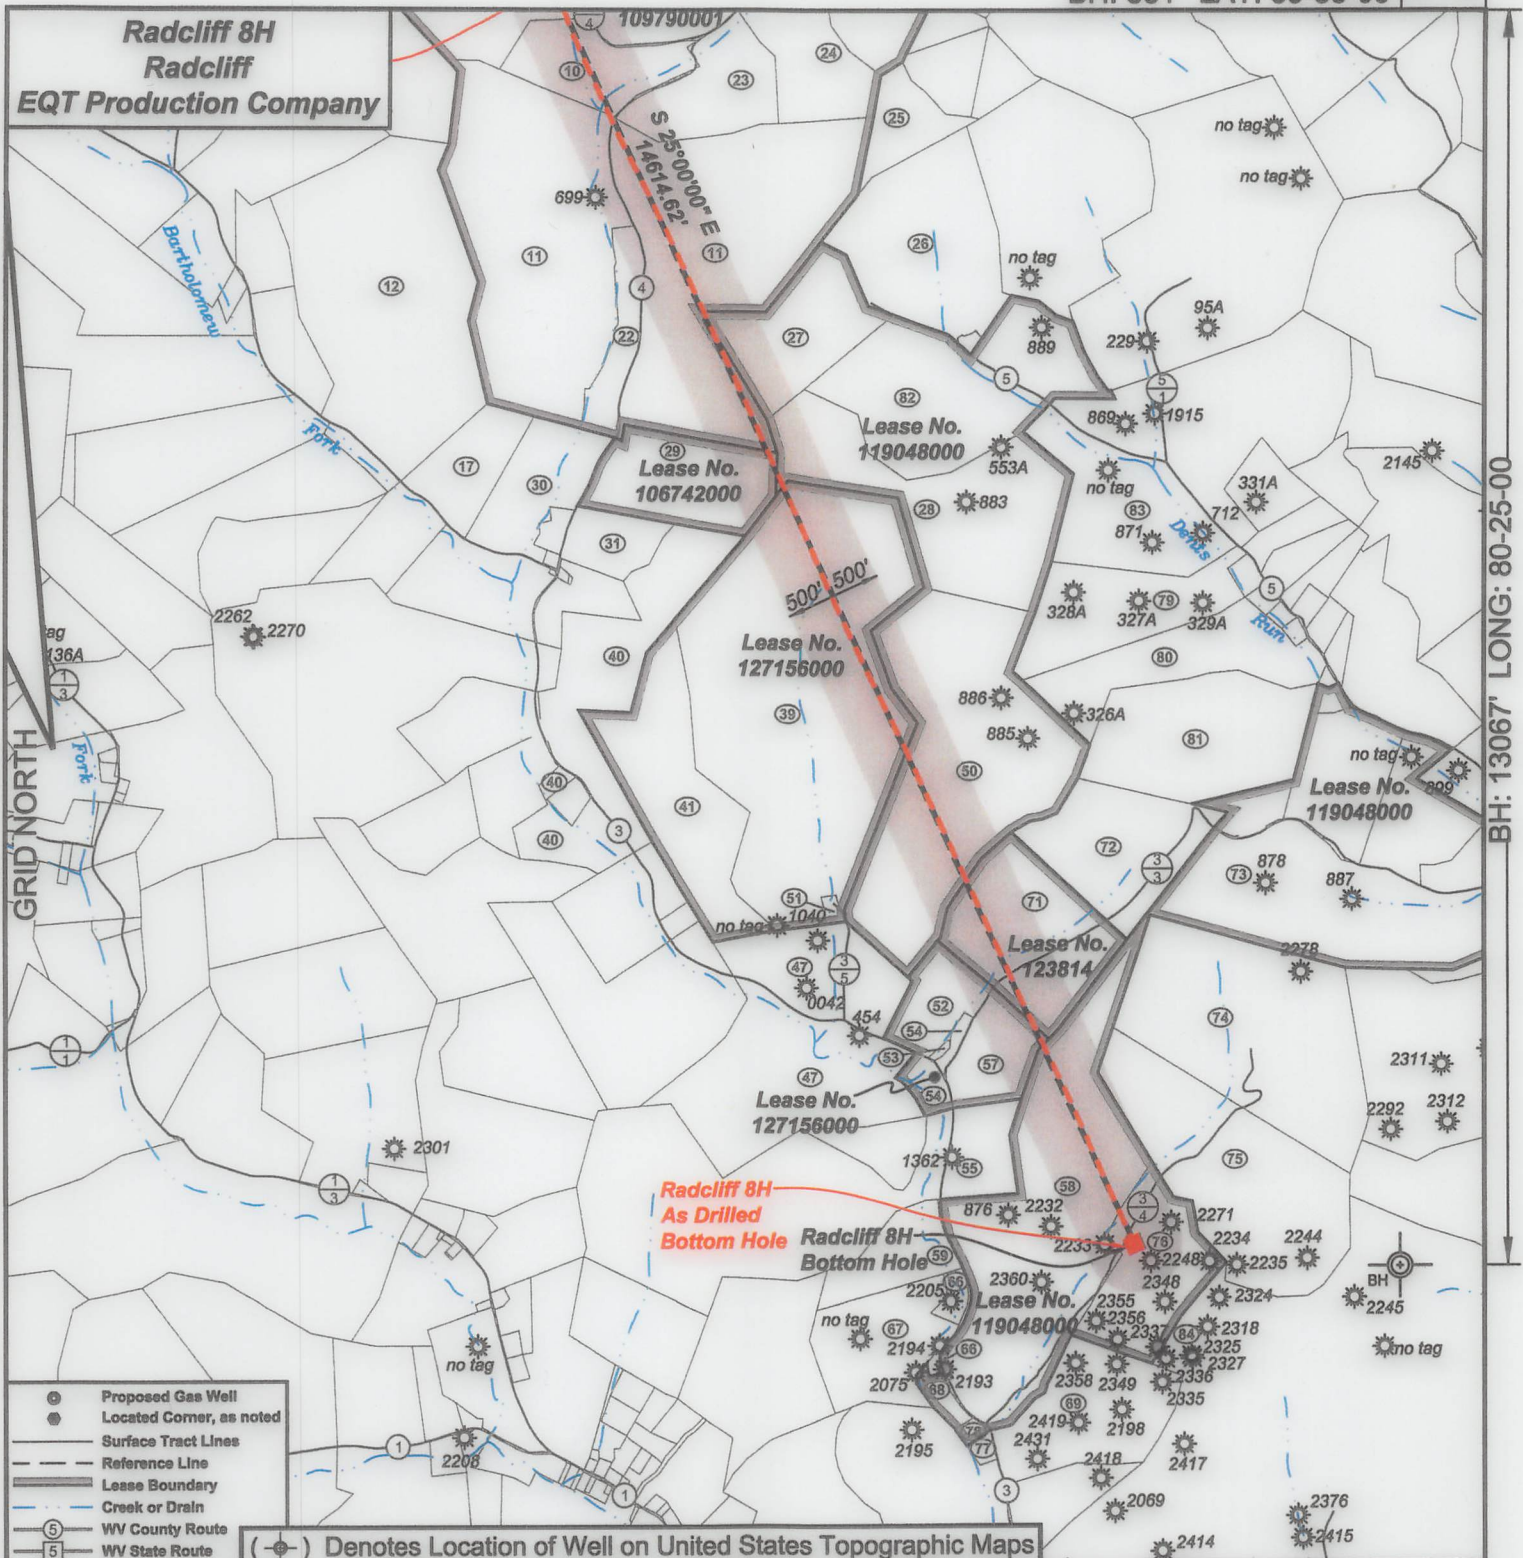

I, the undersigned, hereby certify that this plat is correct to the best of my knowledge and belief and shows all the information required by law and the regulations issued and prescribed by the Department of Environmental Protection.

Ben R. Singleton

P.S. 2092

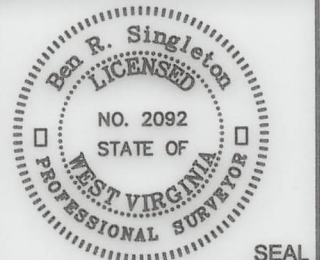

SEAL

FILE NO: 113-21

DRAWING NO: Radcliff 8H

SCALE: 1" = 2000'

MINIMUM DEGREE OF ACCURACY:
1:2500

PROVEN SOURCE OF ELEVATION:
NGS CORS Station

STATE OF WEST VIRGINIA
DEPARTMENT OF ENVIRONMENTAL PROTECTION
OIL AND GAS DIVISION



DATE: March 21 20 24

OPERATOR'S WELL NO.: Radcliff 8H

API WELL NO

47 - 049 - 02518
STATE COUNTY PERMIT

WELL TYPE: ☐ OIL ☒ GAS ☐ LIQUID INJECTION ☐ WASTE DISPOSAL

(IF GAS) PRODUCTION: ☐ STORAGE ☐ DEEP ☒ SHALLOW

LOCATION: ELEVATION: 1493' WATERSHED: Bartholomew Fork QUADRANGLE: Glover Gap

DISTRICT: Mannington COUNTY: Marion

SURFACE OWNER: Jackie D. & Sheila L. Radcliff

ACREAGE: 48.08

ROYALTY OWNER: Rebecca R. Shuttlesworth, et al.

LEASE NO: 109790001

ACREAGE: 1090

PROPOSED WORK: ☒ DRILL ☐ CONVERT ☐ DRILL DEEPER ☒ FRACTURE OR STIMULATE ☐ PLUG OFF OLD FORMATION
☐ PERFORATE NEW FORMATION ☐ OTHER PHYSICAL CHANGE IN WELL (SPECIFY)

☐ PLUG AND ABANDON ☐ CLEAN OUT AND REPLUG TARGET FORMATION: Marcellus ESTIMATED DEPTH: 7916'

WELL OPERATOR: EQT Production Company

DESIGNATED AGENT: Joseph C. Mallow

ADDRESS: 400 Woodcliff Drive


ADDRESS: 427 Midstate Drive

Canonsburg, PA 15317


Clarksburg, WV 26301

04/11/2025

Tract I.D.	Tax Map No.	Parcel No.	County	District	Surface Tract Owner	Acres
1	40	10.1	Marion	Mannington	Jackie D. & Sheila L. Radcliff	48.08
2	40	10	Marion	Mannington	Shelly L. Nelson	43.03
3	40	3	Marion	Mannington	Jason G. & Heather H. Stout	99.75
4	40	2	Marion	Mannington	Lula B. Knight	56.32
5	40	11	Marion	Mannington	Clarence W. Sweeney	63
6	40	12	Marion	Mannington	Jackie D. & Sheila L. Radcliff	27.35
7	40	13	Marion	Mannington	Shelly L. Nelson	19.75
8	40	18	Marion	Mannington	Nimrod Cole	92.12
9	40	17	Marion	Mannington	Steven B. Newbrough	108.7
10	40	23	Marion	Mannington	Sara M. Pascoe, et al.	26.41
11	39	4	Marion	Mannington	Coastal Forest Resources Company	245.722
12	40	22	Marion	Mannington	James & Natalia Kerns	113.25
17	44	14	Marion	Mannington	Charles D. & June Shaver	22.7
22	39	4.1	Marion	Mannington	Thomas R. & Joann McSorley	14.9
23	40	2.2	Marion	Mannington	James W. Boore	29.52
24	40	2.1	Marion	Mannington	Jason G. & Heather R. Stout	29.58
25	39	3	Marion	Mannington	Thomas G. & Theresa A. Jones	10.25
26	39	5	Marion	Mannington	Thomas G. & Theresa A. Jones	61.85
27	38	21.3	Marion	Mannington	David Maffield	37.292
28	38	21	Marion	Mannington	Dennis G. & Louise M. Hayes	74.855
29	38	1	Marion	Mannington	Casey B. & Jennifer J. Allender	38.75
30	44	11	Marion	Mannington	Charles D. & June Shaver	57.75
31	38	2	Marion	Mannington	Justin & Kendra Davis	13.05
39	38	10	Marion	Mannington	Thomas E. & Andrea G. Ryan	176.15
40	38	8	Marion	Mannington	John D. & Rajl K. Carson	64.56
41	38	9	Marion	Mannington	Thomas E. & Andrea G. Ryan	62
47	44	1	Marion	Mannington	Edna Marie Cain	107.5
50	38	11	Marion	Mannington	Yulia Nikolaeva	115
51	38	10.1	Marion	Mannington	Michael E. & Laura A. Gorbey	1.15
52	38	13.3	Marion	Mannington	Christine L. Frapale, et al.	15.87
53	38	13	Marion	Mannington	Cindy Slater, et al.	0.54
54	38	13.2	Marion	Mannington	Christine L. Frapale, et al.	7
55	37	21	Marion	Mannington	Justin R. Cain	129.85
57	38	13.1	Marion	Mannington	Christine L. Frapale, et al.	16.56
58	37	22	Marion	Mannington	Jeffrey H. Michael	166.83
59	37	20	Marion	Mannington	Justin R. Cain	18
66	37	19	Marion	Mannington	Gary E. Snodgrass	3.61
67	37	18	Marion	Mannington	Tommy L. & Terri A. Snodgrass	31.65
68	37	22.1	Marion	Mannington	Ronald C. & Betty L. Michael, et al.	5.17
69	37	17	Marion	Mannington	Jeffrey H. Michael	86.04
71	38	14	Marion	Mannington	Nancy M. Riggs	52
72	38	14.1	Marion	Mannington	John A. Mayhew, Jr.	48
73	37	34	Marion	Mannington	James D. Atkinson	112.5
74	37	23	Marion	Mannington	Christine L. Frapale, et al.	95
75	37	24	Marion	Mannington	Jeffrey H. Michael	79
76	37	25	Marion	Mannington	Jeffrey H. Michael	33.75
77	37	17.1	Marion	Mannington	Ronald C. & Betty L. Michael	1.46
78	37	22.2	Marion	Mannington	Ronald C. & Betty L. Michael	1.5
79	38	19	Marion	Mannington	Dorothy D. Hendershot	38.246
80	38	19.4	Marion	Mannington	William E. Hendershot	39.702
81	38	15	Marion	Mannington	Michael & Julia A. Billie	58.67
82	38	21.2	Marion	Mannington	Douglas E. & Debora J. Maffield	54.669
83	38	20	Marion	Mannington	Dennis G. & Louise M. Hayes	59.24
84	37	28	Marion	Mannington	Harrison County Coal Resources Inc.	91

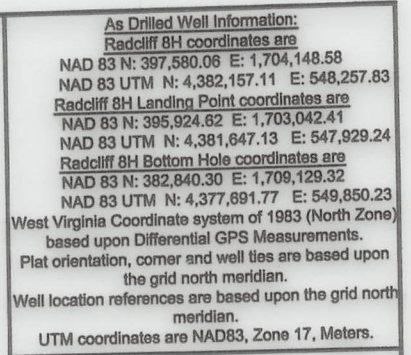


<u>Lease No.</u>	<u>Owner</u>	<u>Acres</u>
109790001	Rebecca R. Shuttlesworth, et al.	1090
119048000	Lee and Hall Royalties, et al.	809
106742000	The Sheila Lightfoot Revocable Trust, et al.	37.25
127156000	EQT Production Company, et al.	240
123814	XTO Energy, Inc.	52
127156000	EQT Production Company, et al.	41

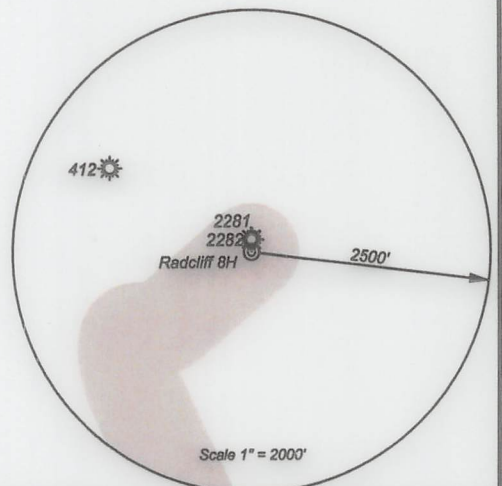

I, the undersigned, hereby certify that this plat is correct to the best of my knowledge and belief and shows all the information required by law and the regulations issued and prescribed by the Department of Environmental Protection.

Ben A. Elton
P.S. 2092

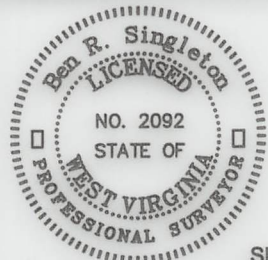

SEAL

FILE NO: 113-21
DRAWING NO: Radcliff 8H
SCALE: 1" = 2000'
MINIMUM DEGREE OF ACCURACY:
1:2500
PROVEN SOURCE OF ELEVATION:
NGS CORS Station

STATE OF WEST VIRGINIA
DEPARTMENT OF ENVIRONMENTAL PROTECTION
OIL AND GAS DIVISION



DATE: March 21 20 24

OPERATOR'S WELL NO.: Radcliff 8H

API WELL NO

47 - 049 - 02518

STATE COUNTY PERMIT

WELL TYPE: ☐ OIL ☒ GAS ☐ LIQUID INJECTION ☐ WASTE DISPOSAL
(IF GAS) PRODUCTION: ☐ STORAGE ☐ DEEP ☒ SHALLOW

LOCATION: ELEVATION: 1493' WATERSHED Bartholomew Fork QUADRANGLE: Glover Gap
DISTRICT: Mannington COUNTY: Marion 04/11/2025
SURFACE OWNER: Jackie D. & Sheila L. Radcliff ACREAGE: 48.08
ROYALTY OWNER: Rebecca R. Shuttlesworth, et al. LEASE NO: 109790001 ACREAGE: 1090
PROPOSED WORK: ☒ DRILL ☐ CONVERT ☐ DRILL DEEPER ☒ FRACTURE OR STIMULATE ☐ PLUG OFF OLD FORMATION
☐ PERFORATE NEW FORMATION ☐ OTHER PHYSICAL CHANGE IN WELL (SPECIFY)
☐ PLUG AND ABANDON ☐ CLEAN OUT AND REPLUG TARGET FORMATION: Marcellus ESTIMATED DEPTH: 7916'

WELL OPERATOR: <u>EQT Production Company</u>	DESIGNATED AGENT: <u>Joseph C. Mallow</u>
ADDRESS: <u>400 Woodcliff Drive</u>	ADDRESS: <u>427 Midstate Drive</u>
<u>Canonsburg, PA 15317</u>	<u>Clarksburg, WV 26301</u>