


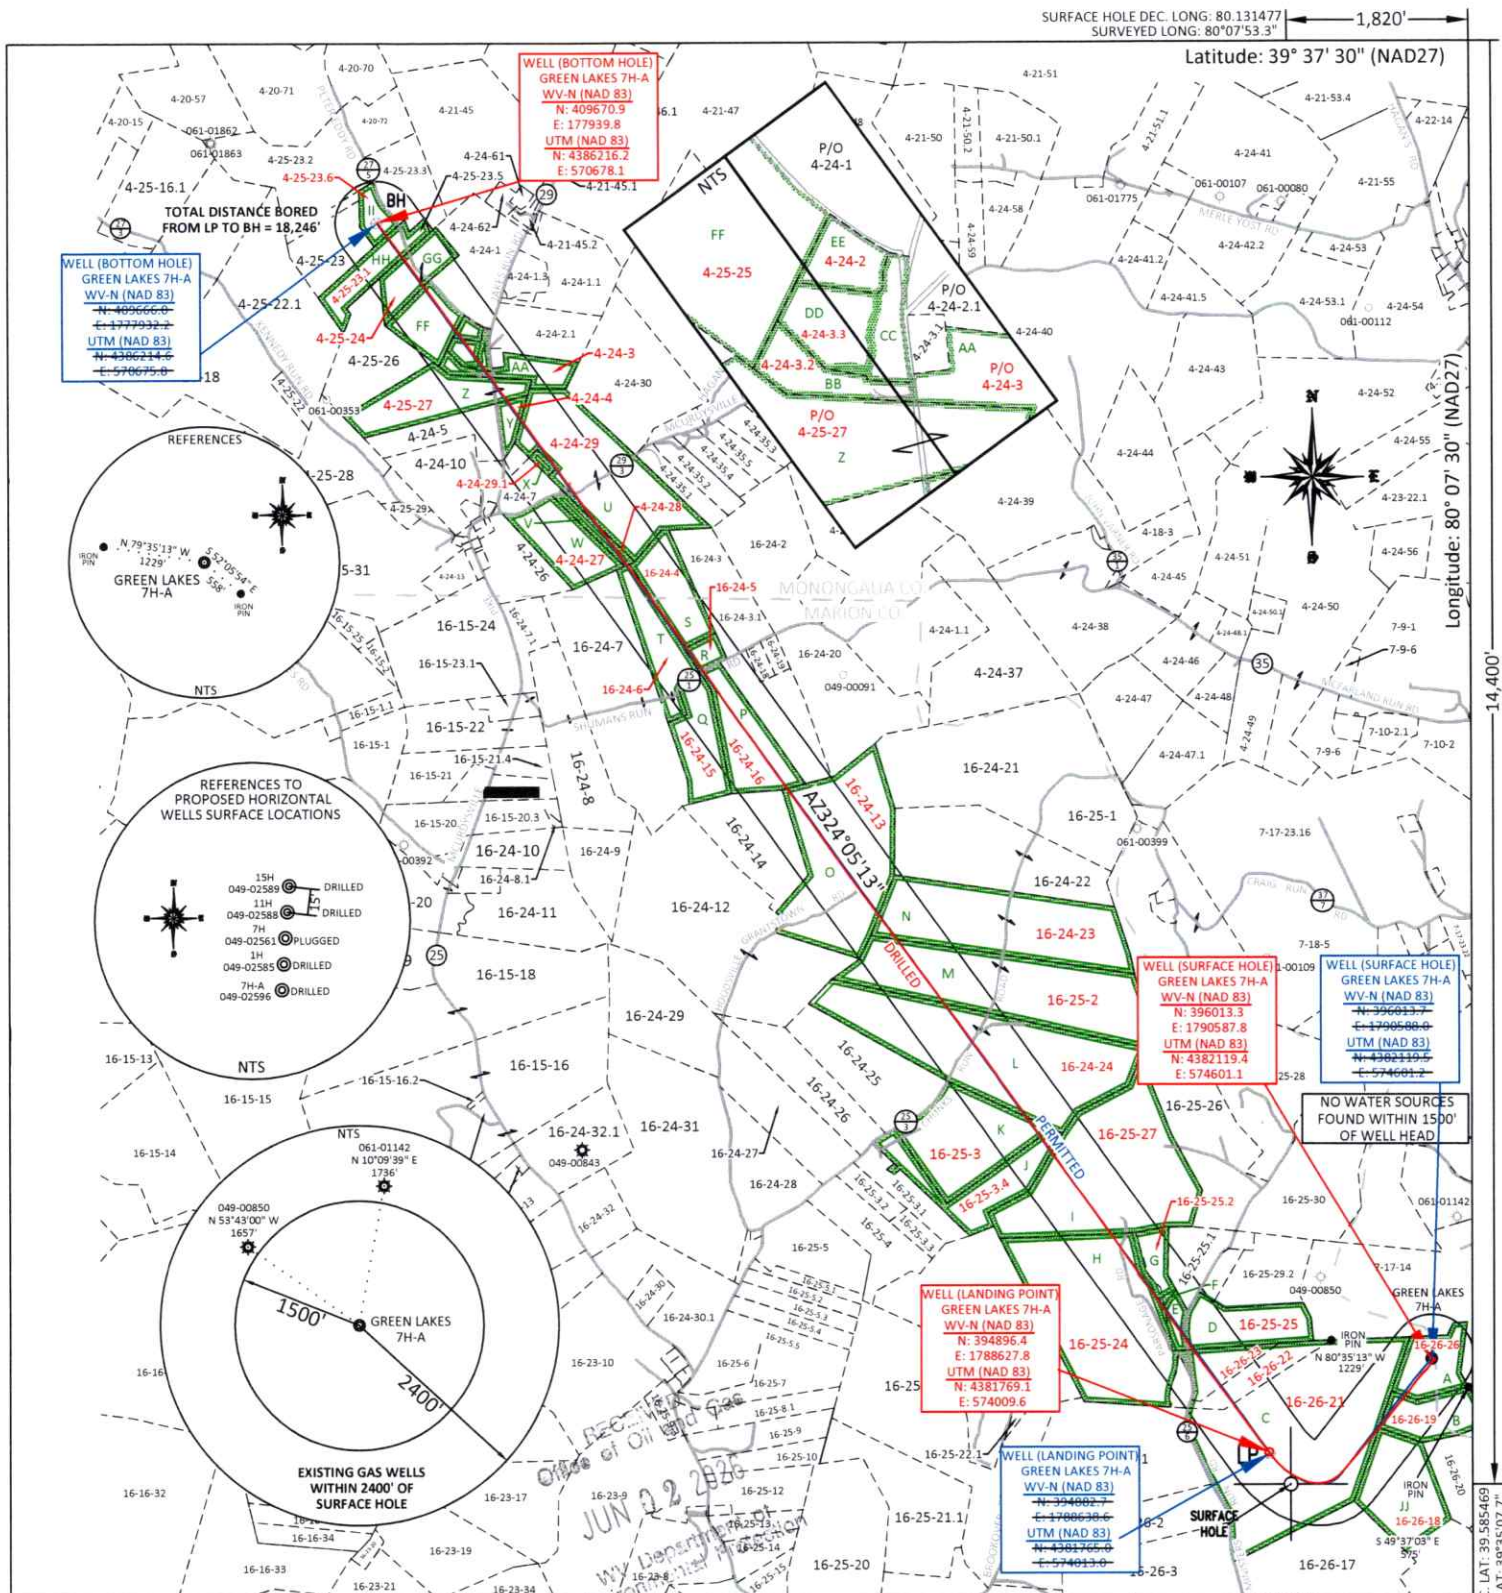

FILE #: NNE20	I, THE UNDERSIGNED, HEREBY CERTIFY THAT THIS	
DRAWING #: 4134	PLAT IS CORRECT TO THE BEST OF MY KNOWLEDGE AND	
SCALE: PLAT: 1" = 2400' TICK: 1" = 2000'	BELIEF AND SHOWS ALL THE INFORMATION REQUIRED BY	
MINIMUM DEGREE OF ACCURACY: 1/200	LAW AND THE REGULATIONS ISSUED AND PRESCRIBED BY	
PROVEN SOURCE OF ELEVATION: SUBMETER MAPPING GRADE GPS	THE DEPARTMENT OF ENVIRONMENTAL PROTECTION.	
Signed: 		
L.L.S. #2124 : Ernest J. Benchek III		

(+) DENOTES LOCATION OF WELL ON UNITED STATES TOPOGRAPHIC MAPS	DATE: APRIL 3, 2026
WVDEP	OPERATOR'S WELL #: GREEN LAKES 7H-A (AS-DRILLED)
OFFICE OF OIL & GAS	API WELL #: 47 49 02596
601 57TH STREET	STATE COUNTY PERMIT
CHARLESTON, WV 25304	AS-BUILT ELEVATION: 1,448.7'
Well Type: ☐ Oil ☐ Waste Diposal ☐ Production ☐ Deep	QUADRANGLE: GRANT TOWN
☒ Gas ☐ Liquid Injection ☐ Storage ☒ Shallow	ACREAGE: 830.72
WATERSHED: Upper Monongahela River	ACREAGE: 12.97 +/-
COUNTY/DISTRICT: MONONGALIA CO., GRANT DISTRICT / MARION CO., PAW PAW DISTRICT	08/21/2026
SURFACE OWNER: Ministers Run Property Management LLC	
OIL & GAS ROYALTY OWNER: Luther E. Howell and Nettie E. Howell	
LEASE NUMBERS:	
DRILL ☐ CONVERT ☐ DRILL DEEPER ☐ REDRILL ☐ FRACTURE OR STIMULATE ☐	
PLUG OFF FORMATION ☐ PERFORATE NEW FORMATION ☐ PLUG & ABANDON ☒	
CLEAN OUT & REPLUG ☐ OTHER CHANGE ☐ (SPECIFY):	
TARGET FORMATION: MARCELLUS	DRILLED DEPTH: PILOT TVD: 8,209' TVD: 7,978' TMD: 27,558'
WELL OPERATOR: NORTHEAST NATURAL ENERGY LLC	DESIGNATED AGENT: JOHN ADAMS
ADDRESS: 707 VIRGINIA STREET EAST, SUITE 1200	ADDRESS: 707 VIRGINIA STREET EAST, SUITE 1200
CITY: CHARLESTON STATE: WV ZIP CODE: 25301	CITY: CHARLESTON STATE: WV ZIP CODE: 25301

PROPERTY INDEX	
4-25-23.6	MICHAEL L & AMBER D PAYTON
4-25-23.1	LONGIN PIOTROWSKI
4-25-24	BARBARA J COPEN
4-25-25	MARION & TONIA MITCHELL
4-24-2	MARION & TONIA MITCHELL
4-24-3.3	SHANNON K SUTPHIN
4-24-3.2	WARREN BROOK TROUT
4-25-27	DAVID S BRACKEN II & DEBRA L SHAFFER
4-24-3	WARREN BROOK TROUT & WARREN BROOK TROUT II
4-24-4	SHUMAN INC
4-24-29	DAVID E EDDY
4-24-29.1	MCCURDYSVILLE CEMETERY
4-24-27	RUTH MARILYN & COREY M HURLEY
4-24-28	RUTH MARILYN & COREY M HURLEY
16-24-4	KEVIN L & JODI L BUTCHER
16-24-5	KEVIN L & JODI L BUTCHER
16-24-6	LLOYD W & WALTER S MUNDELL
16-24-15	RICHARD A MICHAEL
16-24-16	ROBERT HANNAH
16-24-13	STEVE J KISH SR ETAL
16-24-23	GENE J & LORENA M BRAGG
16-25-3	HAROLD E PERKINS
16-25-3.4	REGINA A ENNIS (LIFE 1225-914)
16-25-2	WILLIAM R & JONNETTE D BRAGG
16-24-24	WILLIAM R & JONNETT D BRAGG
16-25-27	RICHARD STEPHEN MICHAEL
16-25-24	JAMES W BURTON III
16-25-25.2	JAMES W BURTON III
16-25-25	HEATHER ALKIRE
16-26-23	MARY A BURTON
16-26-22	JERRY G & SHARON D SISLER
16-26-26	MINISTERS RUN PROPERTY MANAGEMENT LLC
16-26-21	JERRY G & SHARON D SISLER
16-26-19	GARY W DAYTON
16-26-18	GARY W DAYTON

RECEIVED
Office of Oil and Gas
JUN 02 2026
WV Department of
Environmental Protection

LEASE INDEX			
A	WV-049-106675-001	S	WV-049-006364-001
B	WV-049-106358-001	T	WV-049-006322-001
C	WV-049-106380-001	U	WV-061-001377-100
D	WV-049-106638-007	V	WV-061-004574-000
E	WV-049-106638-007	W	WV-061-004359-007
F	WV-049-106688-001	X	WV-061-001377-100
G	WV-049-106679-002	Y	WV-061-004700-003
H	WV-049-106457-001	Z	WV-061-004259-001
I	WV-049-104417-002	AA	WV-061-004295-002
J	WV-049-106493-001	BB	WV-061-004296-002
K	WV-049-086241-001	CC	WV-061-004731-000
L	WV-049-105165-001	DD	WV-061-004731-000
M	WV-049-106604-002	EE	WV-061-004739-001
N	WV-049-104202-010	FF	WV-061-004739-001
O	WV-049-106392-001	GG	WV-061-002330-003
P	WV-049-106592-001	HH	WV-061-003015-015
Q	WV-049-004684-000	II	WV-061-003015-015
R	WV-049-006364-001	JJ	WV-049-106358-001

08/21/2026

FILE #: NEE20
DRAWING #: 4134
SCALE: N/A

DATE: APRIL 3, 2026
OPERATOR'S WELL #: GREEN LAKES 7H-A
API WELL #: 47 49 02596
STATE COUNTY PERMIT

WELL NAME: GREEN LAKES 7H-A
GRANT TOWN



TOTAL DISTANCE BORED
FROM LP TO BH = 18,246'

BLACKSVILLE QUAD

Hagans

McCurdyville

AZ324°05'13"

08/21/2026



GRAPHIC SCALE