


4704902605

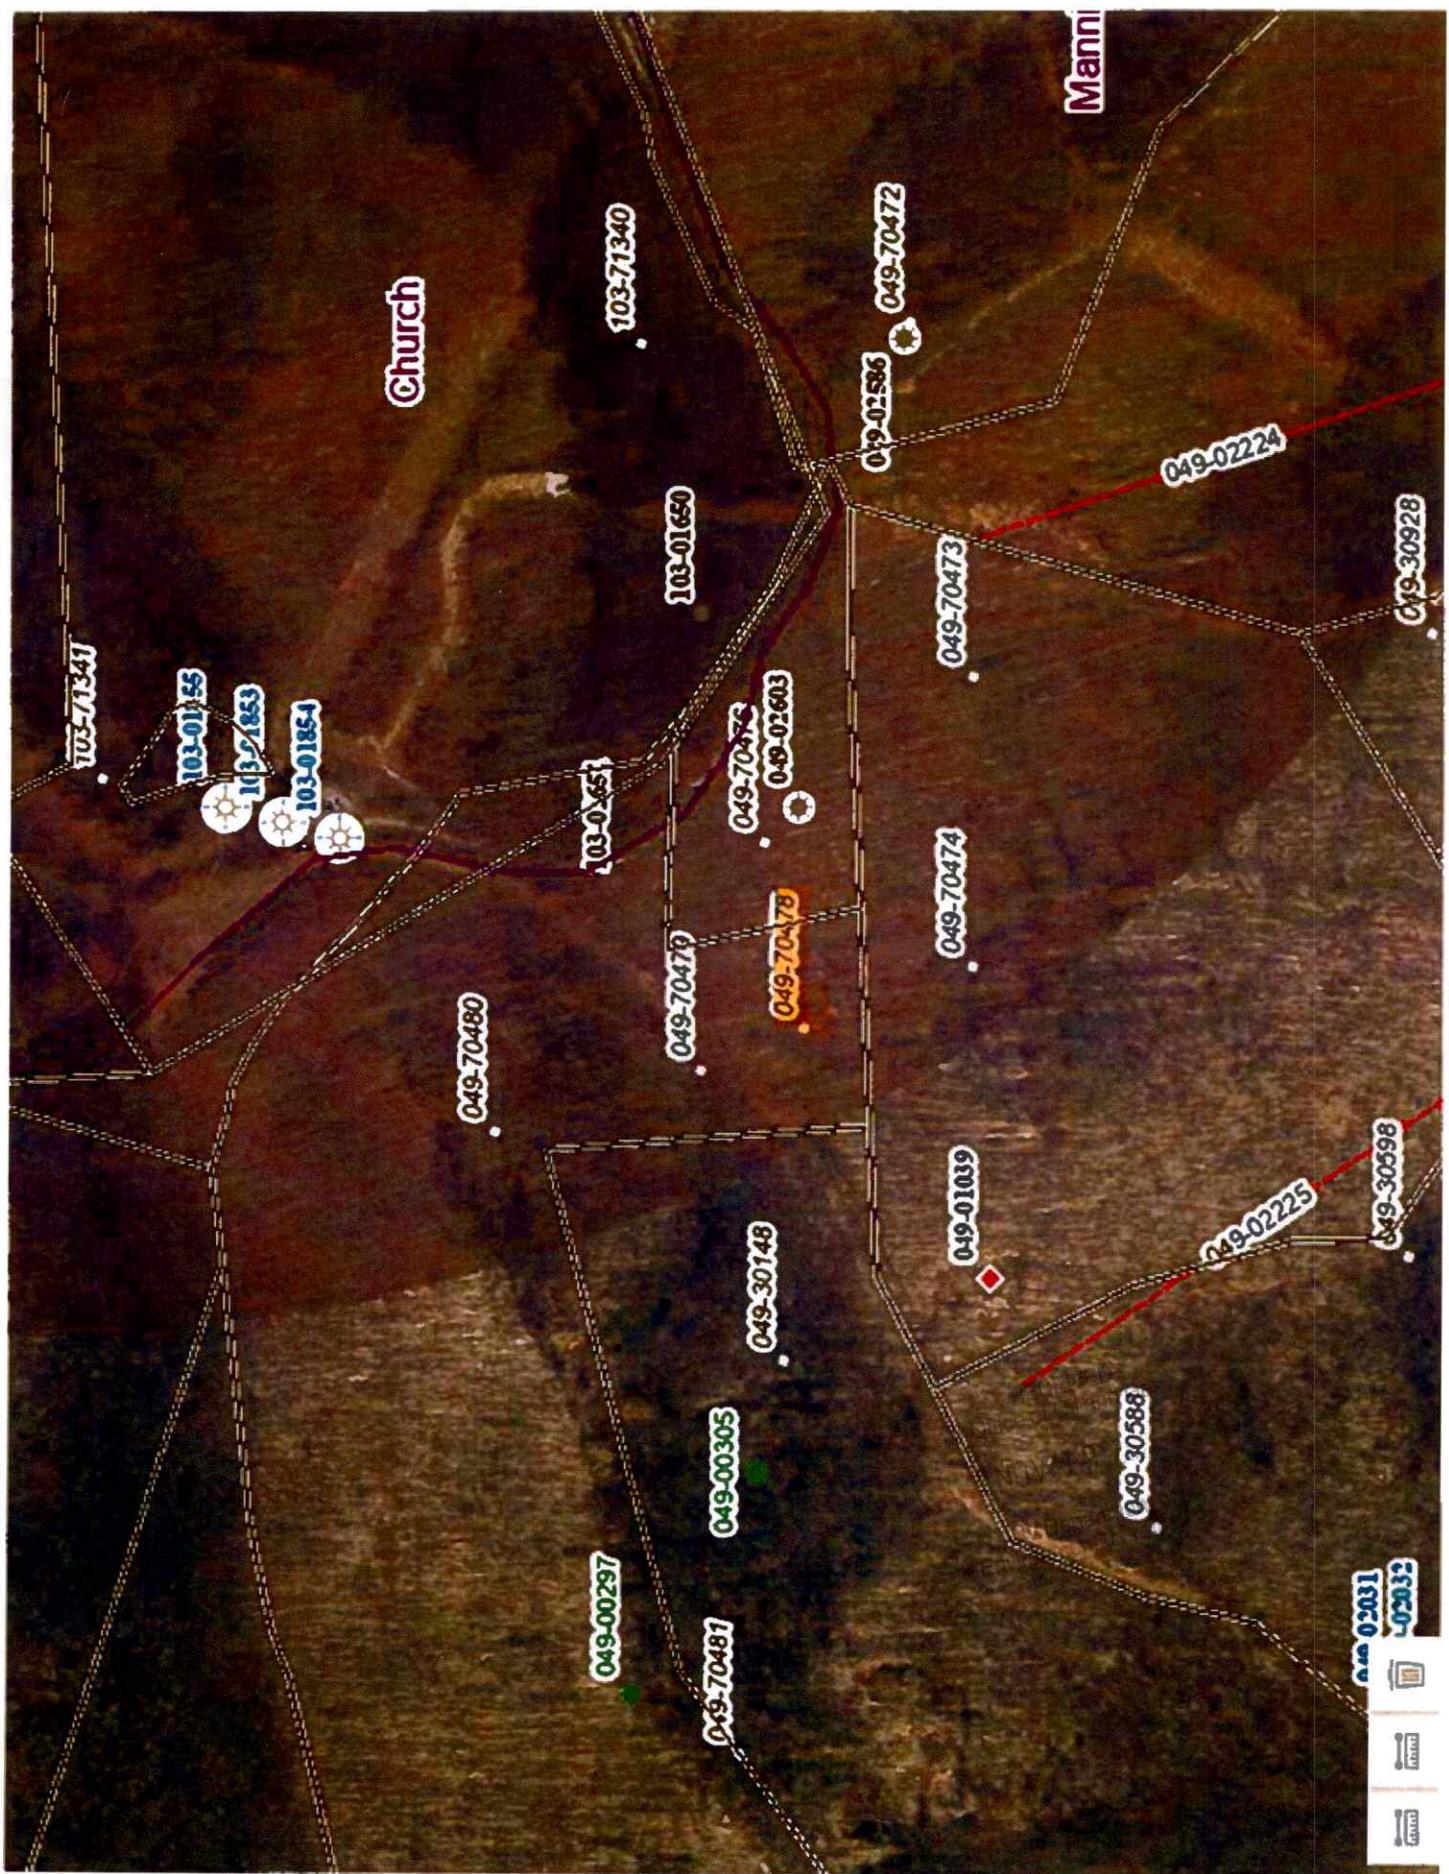

12/05/2025

4704902605


Well# 4711

HUNDRED WV / PA
Scale: 1²⁰⁰⁰ = 2000

Access Road

12/05/2025

4704902605

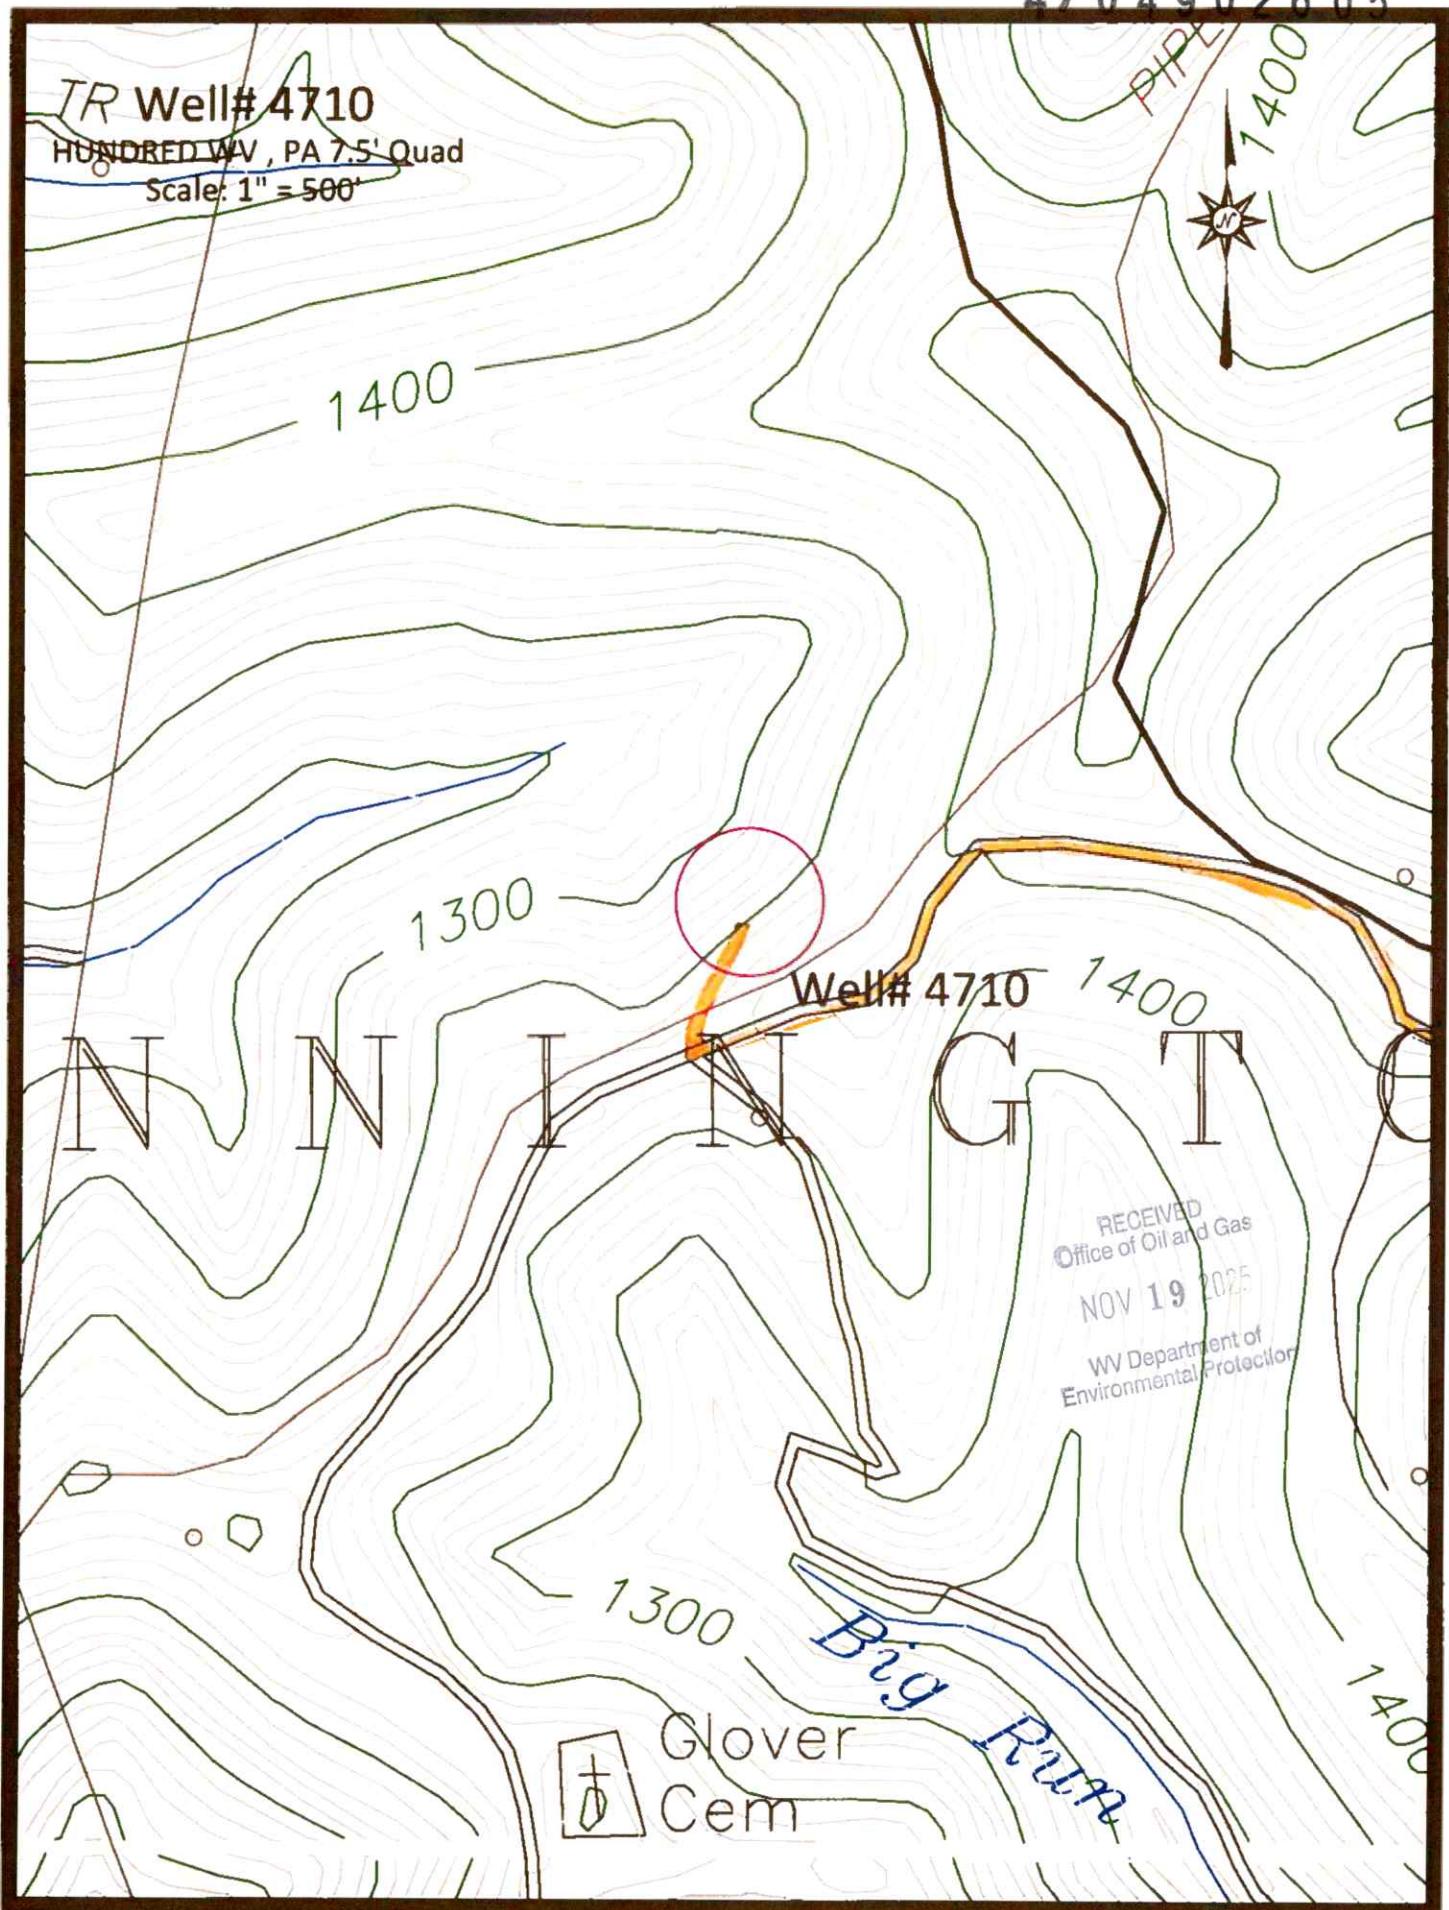

4704902005



39°37'30"

30'
(MANNINGTON)
4983 11 SE

ROAD CLASSIFICATION

U. S. Route State Route

"Hundred: WV.PA' Scale: 1" = 0.379Mi. 610Mt. 2,000Ft. 1 Mi = 2,640". 1 cm = 240Mt.

1858

HUNDRED, W. VA.—PA.
NW/4 MANNINGTON 15' QUADRANGLE
N 3937.5—W 8022.5/7.5

12/05/2025

WW-7
8-30-06

West Virginia Department of Environmental Protection
Office of Oil and Gas
WELL LOCATION FORM: GPS

API: 47-049-70478 WELL NO.: 4710FARM NAME: ROBERT N. CAMPBELLRESPONSIBLE PARTY NAME: WEST VIRGINIA LAND RESOURCES INC.COUNTY: MARION DISTRICT: MANNINGTONQUADRANGLE: HUNDRED WV, PASURFACE OWNER: RENEE E. CAMPBELL

ROYALTY OWNER: _____

UTM GPS NORTHING: 4,387,105 mUTM GPS EASTING: 550,545 m GPS ELEVATION: 425 m

The Responsible Party named above has chosen to submit GPS coordinates in lieu of preparing a new well location plat for a plugging permit or assigned API number on the above well. The Office of Oil and Gas will not accept GPS coordinates that do not meet the following requirements:

1. Datum: NAD 1983, Zone: 17 North, Coordinate Units: meters, Altitude: height above mean sea level (MSL) – meters.

2. Accuracy to Datum – 3.05 meters

3. Data Collection Method:

Survey grade GPS : Post Processed Differential

Real-Time Differential

RECEIVED
Office of Oil and Gas

NOV 19 2002

Mapping Grade GPS : Post Processed Differential _____

Real-Time Differential _____

WV Department of
Environmental Protection

4. Letter size copy of the topography map showing the well location.
I the undersigned, hereby certify this data is correct to the best of my knowledge and belief and shows all the information required by law and the regulations issued and prescribed by the Office of Oil and Gas.

Signature

PS 2002

Title

OCTOBER 30, 2025

Date