


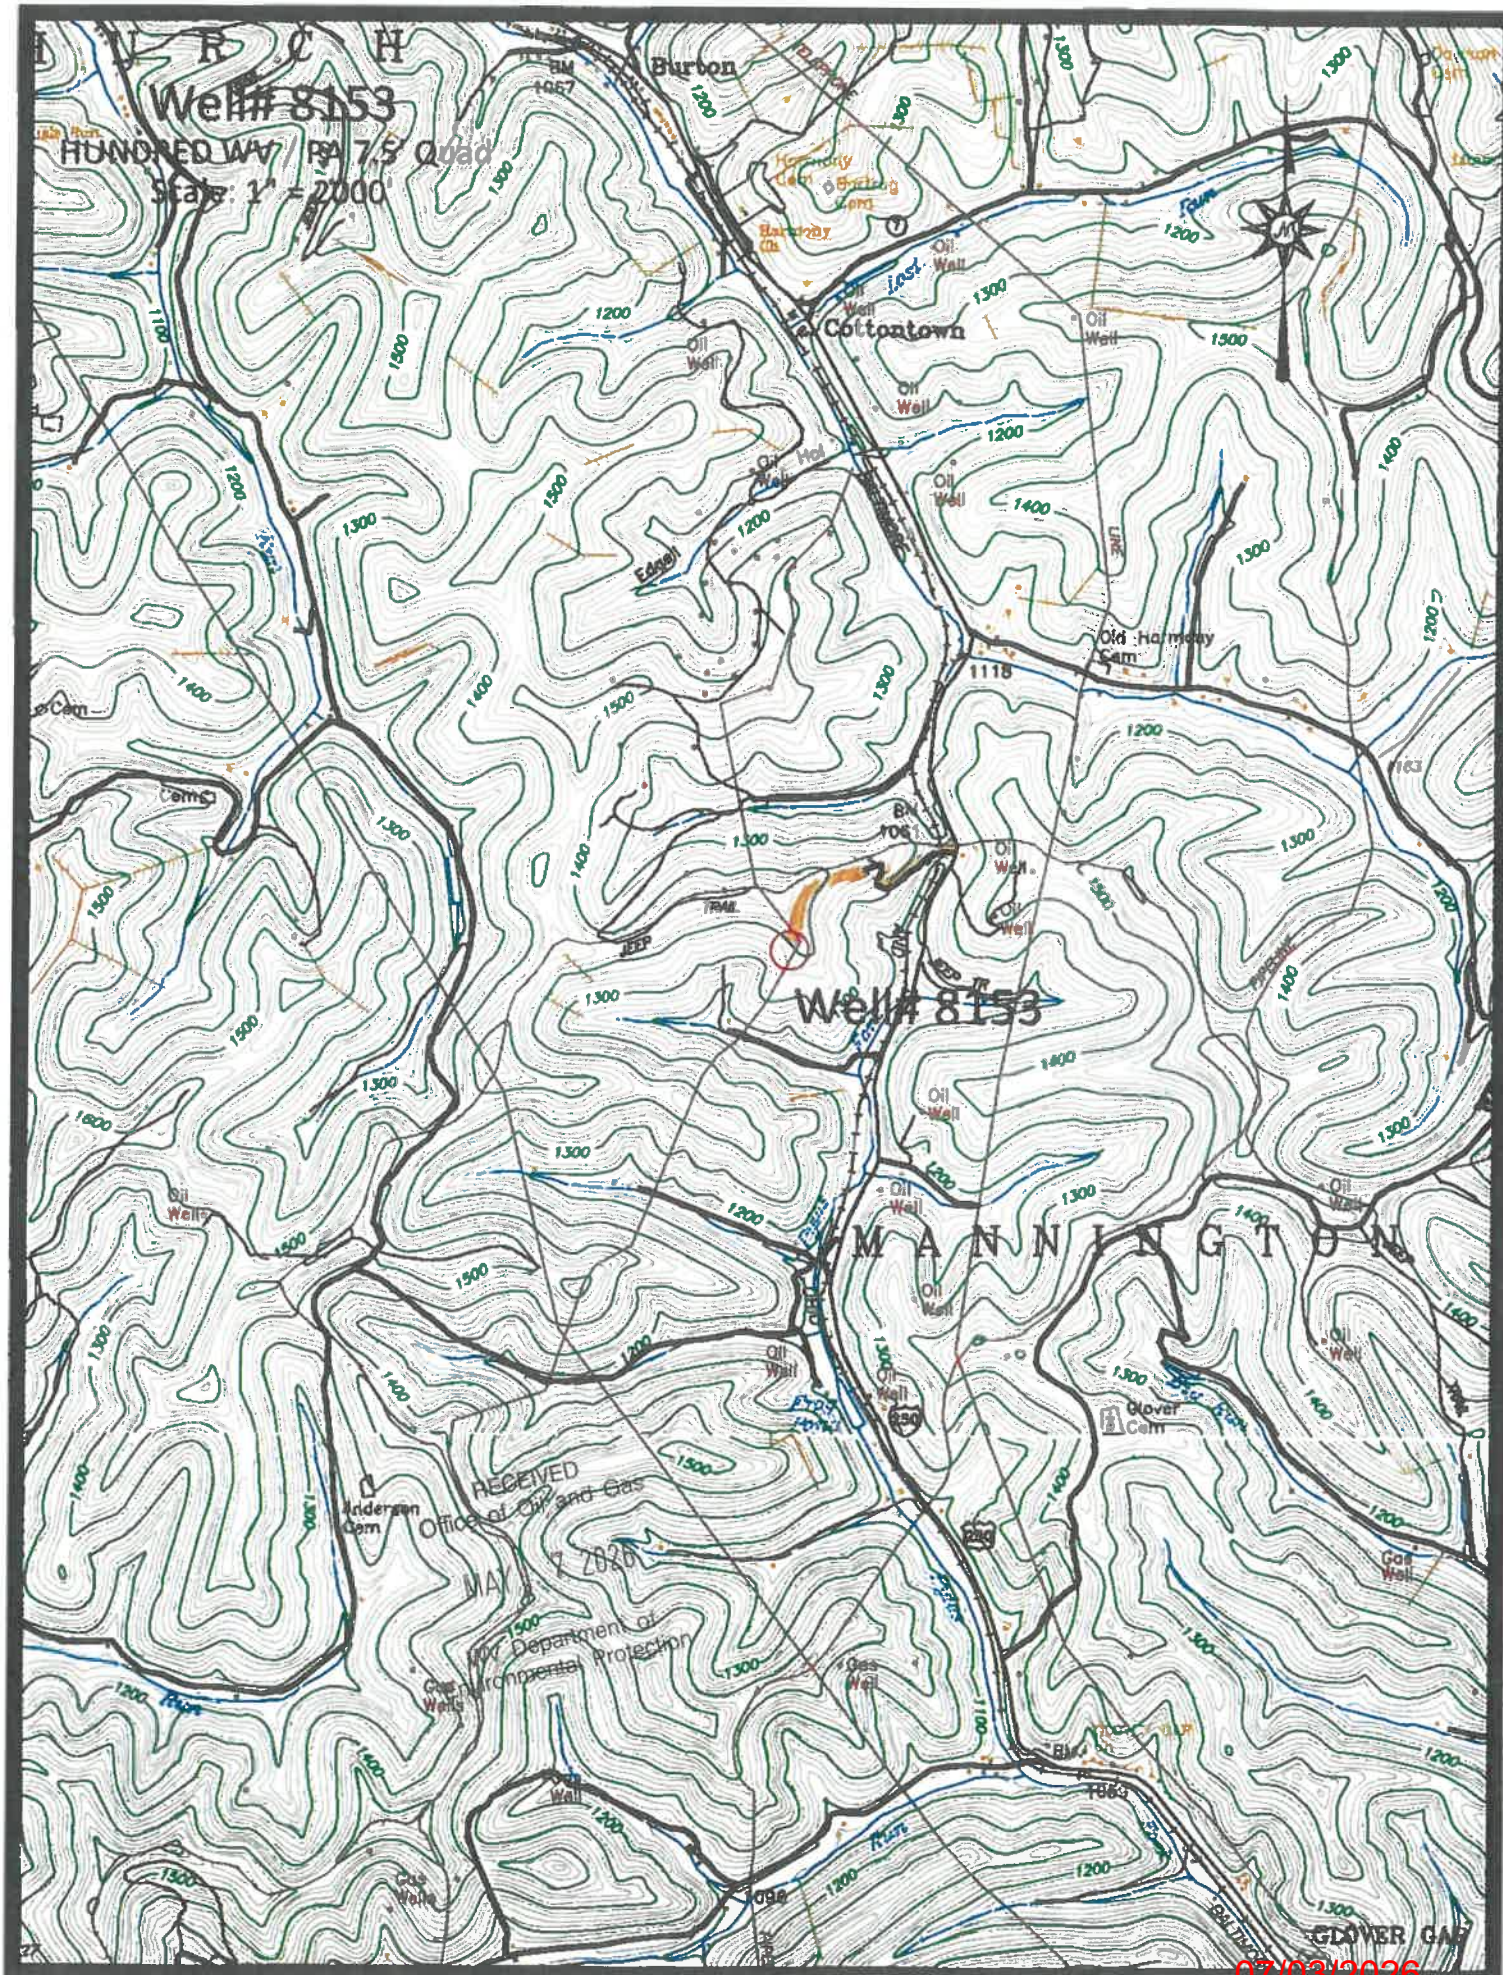

Across Road

07/03/2026

4704002011

Well# 8153

HUNDRED WV / PA 7.5' Quad

Scale: 1" = 500'

BM

1061

1300

TRAIL

JEEP

Well# 8153

1300

Fork

AND

JEEP

Oil Well

1200

Oil Well

RECEIVED
Office of Oil and Gas
MAY 7 2026
WV Department of
Environmental Protection

07/03/2026

n. d. i.



RESERVED
Office of Oil and Gas
MAY 7 2026
WV Department of Environmental Protection

46 47 48 (GLOVER GAP) 49 25
4963 III SW
SCALE 1:24 000
1 MILE
0 1000 2000 3000 4000 5000 6000 7000 FEET
1 .5 0 1 KILOMETER
CONTOUR INTERVAL 20 FEET
NATIONAL GEODETIC VERTICAL DATUM OF 1929
'Hundred; WV,PA' Scale: 1" = 0.360Mi 580Mt 1,902ft, 1 Mi = 2.776" , 1 cm = 228Mt

GLOVER GAP 1.5 MI
FAIRMONT 23 MI.

07/03/2026



West Virginia Department of Environmental Protection
Office of Oil and Gas

WELL LOCATION FORM: GPS

API: 47-049-70494 WELL NO.: 8153

FARM NAME: WM. TROY

RESPONSIBLE PARTY NAME: WEST VIRGINIA LAND RESOURCES INC.

COUNTY: MARION DISTRICT: MANNINGTON

QUADRANGLE: HUNDRED WV, PA

SURFACE OWNER: MARION COUNTY COAL RESOURCES INC.

ROYALTY OWNER: _____

UTM GPS NORTHING: 4,387,855 m 1394 FEET

UTM GPS EASTING: 549,386 m GPS ELEVATION: 425 m

The Responsible Party named above has chosen to submit GPS coordinates in lieu of preparing a new well location plat for a plugging permit or assigned API number on the above well. The Office of Oil and Gas will not accept GPS coordinates that do not meet the following requirements:

1. Datum: NAD 1983, Zone: 17 North, Coordinate Units: meters, Altitude: height above mean sea level (MSL) – meters.
2. Accuracy to Datum – 3.05 meters
3. Data Collection Method:

Survey grade GPS X : Post Processed Differential _____

Real-Time Differential X

Mapping Grade GPS _____ : Post Processed Differential _____

Real-Time Differential _____

RECEIVED
Office of Oil and Gas

MAY 7 2026

WV Department of
Environmental Protection

4. **Letter size copy of the topography map showing the well location.**

I the undersigned, hereby certify this data is correct to the best of my knowledge and belief and shows all the information required by law and the regulations issued and prescribed by the Office of Oil and Gas.

Signature

Title

JANUARY 30, 2026

Date

07/03/2026